

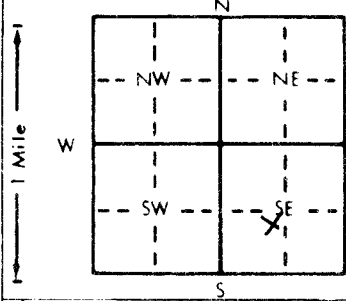
1 LOCATION OF WATER WELL:	Fraction	Section Number	Township Number	Range Number
County: <u>Barton</u>	<u>NE 1/4 SW 1/4 SE 1/4</u>	<u>12</u>	T <u>19</u> <u>Q</u>	R <u>13</u> <u>EW</u>

Distance and direction from nearest town or city street address of well if located within city?

8 miles North of Great Bend Ks on Hwy 156

2 WATER WELL OWNER:	RR#, St. Address, Box #	City, State, ZIP Code	Board of Agriculture, Division of Water Resources
<u>Barton Co. Landfill</u>	<u>Northeast 30 Rd</u>	<u>Barton Co. Ks</u>	Application Number:

3 LOCATE WELL'S LOCATION WITH AN "X" IN SECTION BOX:	4 DEPTH OF COMPLETED WELL	ELEVATION
--	---------------------------	-----------

Depth(s) Groundwater Encountered 1. 64.5 ft. 2. — ft. 3. — ft.WELL'S STATIC WATER LEVEL 0 ft. below land surface measured on mo/day/yrPump test data: Well water was — ft. after — hours pumping — gpmEst. Yield — gpm Well water was — ft. after — hours pumping — gpmBore Hole Diameter 8 1/4 in. to 64.5 ft., and — in. to — ft.

WELL WATER TO BE USED AS: 5 Public water supply 8 Air conditioning 11 Injection well

1 Domestic 3 Feedlot 6 Oil field water supply 9 Dewatering 12 Other (Specify below)

2 Irrigation 4 Industrial 7 Lawn and garden only 10 Monitoring wellWas a chemical/bacteriological sample submitted to Department? Yes — No X If yes, mo/day/yr sample was submittedWater Well Disinfected? Yes — No X

5 TYPE OF BLANK CASING USED:	5 Wrought iron	8 Concrete tile	CASING JOINTS: Glued <u>—</u> Clamped <u>—</u>
------------------------------	----------------	-----------------	--

1 Steel 3 RMP (SR) 6 Asbestos-Cement 9 Other (specify below) Welded —2 PVC 4 ABS 7 Fiberglass Threaded XBlank casing diameter 2 in. to 48.0 ft., Dia — in. to — ft., Dia — in. to — ft.Casing height above land surface 2.5 in., weight 5.5 lb./ft. Wall thickness or gauge No. —TYPE OF SCREEN OR PERFORATION MATERIAL: 7 PVC 10 Asbestos-cement

1 Steel 3 Stainless steel 5 Fiberglass 8 RMP (SR) 11 Other (specify)

2 Brass 4 Galvanized steel 6 Concrete tile 9 ABS 12 None used (open hole)

SCREEN OR PERFORATION OPENINGS ARE: 5 Gauzed wrapped 8 Saw cut 11 None (open hole)

1 Continuous slot 3 Mill slot 6 Wire wrapped 9 Drilled holes

2 Louvered shutter 4 Key punched 7 Torch cut 10 Other (specify)

SCREEN-PERFORATED INTERVALS: From 48.0 ft. to 64.0 ft. From — ft. to — ft.From 44.0 ft. to 64.5 ft. From — ft. to — ft.GRAVEL PACK INTERVALS: From — ft. to — ft. From — ft. to — ft.From — ft. to — ft. From — ft. to — ft.6 GROUT MATERIAL: 1 Neat cement 2 Cement grout 3 Bentonite 4 OtherGrout Intervals: From 0.0 ft. to 2.0 ft. From 2.0 ft. to 47.0 ft. From — ft. to — ft.

What is the nearest source of possible contamination: 10 Livestock pens 14 Abandoned water well

1 Septic tank 4 Lateral lines 7 Pit privy 11 Fuel storage 15 Oil well/Gas well

2 Sewer lines 5 Cess pool 8 Sewage lagoon 12 Fertilizer storage 16 Other (specify below)3 Watertight sewer lines 6 Seepage pit 9 Feedyard 13 Insecticide storage Landfill

Direction from well? How many feet?

FROM TO LITHOLOGIC LOG FROM TO PLUGGING INTERVALS

0.0 1.0 Topsoil

1.0 63.0 sa b-cl & Br.

63.0 64.5 Fcl w/ sa Rd Br.

OFFICE USE ONLY

T

R

EW

SEC.

1/4

1/4

1/4