


1 LOCATION OF WATER WELL:	Fraction <i>NW 1/4 NW 1/4</i>	Section Number	Township Number	Range Number
County: <i>BARTON</i>	<i>1/4 NW 1/4</i>	<i>29</i>	<i>T 19 S</i>	<i>R 13 E/W</i>

Distance and direction from nearest town or city street address of well if located within city?

2001 LINCOLN

2 WATER WELL OWNER: <i>MRS. ROBERT POLSON</i>	Board of Agriculture, Division of Water Resources
RR#, St. Address, Box # <i>2001 LINCOLN</i>	Application Number:
City, State, ZIP Code <i>GREAT BEND, KS. 67530</i>	

3 LOCATE WELL'S LOCATION WITH AN "X" IN SECTION BOX:	4 DEPTH OF COMPLETED WELL: <i>65</i> ft. ELEVATION:
--	---

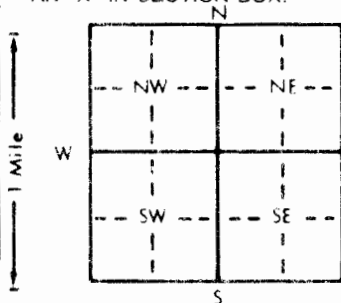

Depth(s) Groundwater Encountered	1. ft.	2. ft.	3. ft.
WELL'S STATIC WATER LEVEL	<i>1.9</i> ft. below land surface measured on mo/day/yr		
Pump test data:	Well water was	ft. after	hours pumping
Est. Yield	gpm	Well water was	ft. after
Bore Hole Diameter	<i>.9</i> in. to	ft. and	in. to
WELL WATER TO BE USED AS:	5 Public water supply	8 Air conditioning	11 Injection well
☒ 1 Domestic	3 Feedlot	6 Oil field water supply	9 Dewatering
2 Irrigation	4 Industrial	7 Lawn and garden only	10 Monitoring well
Was a chemical/bacteriological sample submitted to Department? Yes No ☒ If yes, mo/day/yr sample was submitted			
Water Well Disinfected? Yes ☒ No			

5 TYPE OF BLANK CASING USED:	5 Wrought iron	8 Concrete tile	CASING JOINTS: Glued ☒ Clamped
1 Steel	3 RMP (SR)	6 Asbestos-Cement	9 Other (specify below)
☒ PVC	4 ABS	7 Fiberglass	Welded
			Threaded

Blank casing diameter *.5* in. to *55* ft. Dia. in. to ft. Dia. in. to ft.

Casing height above land surface *2.4* in. weight lbs./ft. Wall thickness or gauge No.

TYPE OF SCREEN OR PERFORATION MATERIAL:	☒ PVC	10 Asbestos-cement
1 Steel	3 Stainless steel	5 Fiberglass
2 Brass	4 Galvanized steel	6 Concrete tile
		8 RMP (SR)
		9 ABS
		11 Other (specify)
		12 None used (open hole)

SCREEN OR PERFORATION OPENINGS ARE:	5 Gauzed wrapped	8 Saw cut	11 None (open hole)
1 Continuous slot	☒ 3 Mill slot	6 Wire wrapped	9 Drilled holes
2 Louvered shutter	4 Key punched	7 Torch cut	10 Other (specify)

SCREEN-PERFORATED INTERVALS:	From <i>55</i> ft. to <i>65</i> ft.	From ft. to ft.
	From ft. to ft.	From ft. to ft.
GRAVEL PACK INTERVALS	From <i>23</i> ft. to <i>65</i> ft.	From ft. to ft.
	From ft. to ft.	From ft. to ft.

6 GROUT MATERIAL:	1 Neat cement	☒ Cement grout	☒ Bentonite	4 Other
Grout Intervals:	From # <i>3</i> ft. to <i>23</i> ft.	From ft. to ft.	From ft. to ft.	From ft. to ft.

What is the nearest source of possible contamination:	10 Livestock pens	14 Abandoned water well
1 Septic tank	4 Lateral lines	7 Pit privy
2 Sewer lines	5 Cess pool	8 Sewage lagoon
3 Watertight sewer lines	6 Seepage pit	9 Feedyard
		11 Fuel storage
		12 Fertilizer storage
		13 Insecticide storage
		NONE KNOWN

Direction from well? How many feet?

FROM	TO	LITHOLOGIC LOG	FROM	TO	PLUGGING INTERVALS
0	3	TOP SOIL			
3	17	CLAY			
17	34	GRAVEL			
34	48	CLAY			
48	65	GRAVEL			

7 CONTRACTOR'S OR LANDOWNER'S CERTIFICATION: This water well was ☒ (1) constructed, (2) reconstructed, or (3) plugged under my jurisdiction and was completed on (mo/day/year) <i>9-12-94</i> and this record is true to the best of my knowledge and belief. Kansas Water Well Contractor's License <i>462</i> This Water Well Record was completed on (mo/day/yr) <i>9-19-94</i> under the business name of <i>SAM'S WATER WELL SERVICE</i> by (signature) <i>Don Raylen</i>
--

INSTRUCTIONS: Use typewriter or ball point pen. PLEASE PRESS FIRMLY and PRINT clearly. Please fill in blanks, underline or circle the correct answers. Send top three copies to Kansas Department of Health and Environment Bureau of Water, Topeka, Kansas 66620-0001. Telephone: 913-296-5545. Send one to WATER WELL OWNER and retain one for your records.

OFFICE USE ONLY

T

R

E/W

SEC.

1/4

1/4

1/4