


1 LOCATION OF WATER WELL:		Fraction	Section Number	Township Number	Range Number
County:	Barton	NE $\frac{1}{4}$ NE $\frac{1}{4}$ NE $\frac{1}{4}$	34	T 19 S	R 14 EW

Distance and direction from nearest town or city street address of well if located within city?

DMW-11

2 WATER WELL OWNER: Fuller Brush
RR#, St. Address, Box # :
City, State, ZIP Code : Great Bend, KS

3 LOCATE WELL'S LOCATION WITH AN "X" IN SECTION BOX: 4 DEPTH OF COMPLETED WELL: 45 ft. ELEVATION: 12 ft

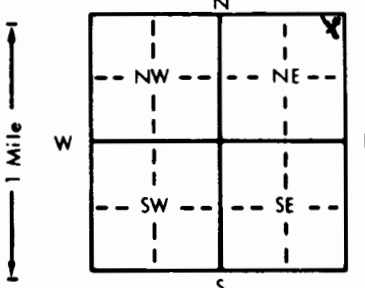

4) DEPTH OF COMPLETED WELL 45 ft. ELEVATION: _____

Depth(s) Groundwater Encountered 12 ft. 2. _____ ft. 3. _____ ft.

WELL'S STATIC WATER LEVEL 12 ft. below land surface measured on mo/day/yr 7/95

Pump test data: Well water was _____ ft. after _____ hours pumping _____ gpm

Est. Yield _____ gpm Well water was _____ ft. after _____ hours pumping _____ gpm

Bore Hole Diameter 8 in. to 45 ft., and _____ in. to _____ ft.

WELL WATER TO BE USED AS:

1 Domestic	3 Feedlot	6 Oil field water supply	8 Air conditioning	11 Injection well
2 Irrigation	4 Industrial	7 Lawn and garden only	9 Dewatering	12 Other (Specify below)
			10 Monitoring well	

Was a chemical/bacteriological sample submitted to Department? Yes _____ No X; If yes, mo/day/yr sample was submitted _____

Water Well Disinfected? Yes _____ No X

5	TYPE OF BLANK CASING USED:	5 Wrought iron	8 Concrete tile	CASING JOINTS: Glued Clamped
	1 Steel 3 RMP (SR)	6 Asbestos-Cement	9 Other (specify below)	Welded X

Blank casing diameter 2 in. to 35 ft. Dia. in. to . ft. Dia. in. to . ft.
Casing height above land surface 0 in. weight 69 lbs./ft. Wall thickness or gauge No. .

TYPE OF SCREEN OR PERFORATION MATERIAL:				
1 Steel	3 Stainless steel	5 Fiberglass	7 PVC	10 Asbestos-cement
2 Brass	4 Galvanized steel	6 Concrete tile	8 RMP (SR)	11 Other (specify)
			9 ABS	12 None used (open hole)

SCREEN OR PERFORATION OPENINGS ARE:

1 Continuous slot	3 Mill slot	5 Gauzed wrapped	8 Saw cut	11 None (open hole)
2 Louvered shutter	4 Key punched	6 Wire wrapped	9 Drilled holes	
		7 Torch cut	10 Other (specify)	

SCREEN-PERFORATED INTERVALS:	From 5	ft. to 15	ft., From	ft. to	ft.
	From	ft. to	ft., From	ft. to	ft.
GRAVEL PACK INTERVALS:	From 30	ft. to 45	ft., From	ft. to	ft.
	From	ft. to	ft., From	ft. to	ft.

6 GROUT MATERIAL: 1 Neat cement 2 Cement grout 3 Bentonite 4 Other
Grout Intervals: From 0 ft. to 20 ft., From 20 ft. to 30 ft., From ft. to ft.

What is the nearest source of possible contamination:

1 Septic tank	4 Lateral lines	7 Pit privy	10 Livestock pens	14 Abandoned water well
2 Sewer lines	5 Cess pool	8 Sewage lagoon	11 Fuel storage	15 Oil well/Gas well
3 Watertight sewer lines	6 Seepage pit	9 Feedyard	12 Fertilizer storage	16 Other (specify below)

Direction from well? *E-NE*

How many feet? *~400*

dry well

Direction from well?		How many feet?	
FROM	TO	LITHOLOGIC LOG	PLUGGING INTERVALS

[illegible]

7 CONTRACTOR'S OR LANDOWNER'S CERTIFICATION: This water well was (1) constructed, (2) reconstructed, or (3) plugged under my jurisdiction and was completed on (mo/day/year) 8/30/95 and this record is true to the best of my knowledge and belief. Kansas Water Well Contractor's License No. 581 This Water Well Record was completed on (mo/day/year) 9/3/95 under the business name of Layne, Inc. by (signature) Steven R. Mitchel