

1 LOCATION OF WATER WELL: County: Barton	Fraction SW ¼ NE ¼ NW ¼	Section Number 36	Township Number T 19 S	Range Number R 14 E/W
--	-----------------------------------	-----------------------------	----------------------------------	---------------------------------

Distance and direction from nearest town or city street address of well if located within city?
1130' FNL, 1920' FWL


2 WATER WELL OWNER: **Plating, Inc**RR#, St. Address, Box # : **8801 W. 6th, West Port Addition**

Board of Agriculture, Division of Water Resources

City, State, ZIP Code : **Great Bend, Kansas 67530**

Application Number:

3 LOCATE WELL'S LOCATION WITH AN "X" IN SECTION BOX:

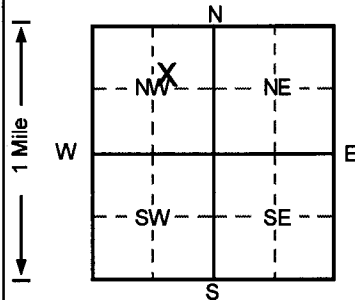

4 DEPTH OF COMPLETED WELL	58	ft.	ELEVATION:	999	ft.	
Depth(s) Groundwater Encountered	1	ft.	2	999	ft.	
WELL'S STATIC WATER LEVEL	999	ft.	below land surface measured on mo/day/yr			
Pump test data: Well water was	NA	ft.	after		hours pumping	
Est. Yield	NA	gpm	Well water was		ft. after	
Bore Hole Diameter	13	in.	to	30	ft.	
WELL WATER TO BE USED AS:	5	Public water supply	8	Air conditioning	11	Injection well
	1	Domestic	3	Feedlot	6	Oil field water supply
	2	Irrigation	4	Industrial	7	Lawn and garden only
Was a chemical/bacteriological sample submitted to Department?	Yes		No			
Water Well Disinfected?	Yes		No			

5 TYPE OF BLANK CASING USED:

1 Steel	3 RMP (SR)	5 Wrought iron	8 Concrete tile	CASING JOINTS: Glued	Clamped		
2 PVC	4 ABS	6 Asbestos-Cement	9 Other (specify below)	Welded			
Blank casing diameter	9	Steel in. to	30	ft.	Dia		
Casing height above land surface	24	in.	weight	2	PVC in. to		
TYPE OF SCREEN OR PERFORATION MATERIAL	7	PVC	10	Asbestos-cement			
1 Steel	3 Stainless steel	5 Fiberglass	8 RMP (SR)	11 Other (specify)			
2 Brass	4 Galvanized steel	6 Concrete tile	9 ABS	12 None used (open hole)			
SCREEN OR PERFORATION OPENINGS ARE:	3	Will slot	5	Gauzed wrapped	8	Saw cut	
1 Continuous slot	2	Louvered shutter	4	Key punched	9	Drilled holes	
SCREEN-PERFORATED INTERVALS:	43	ft. to	58	ft.	From	40	ft. to
GRAVEL PACK INTERVALS:	40	ft. to	60	ft.	From	40	ft. to






FROM	TO	LITHOLOGIC LOG	FROM	TO	PLUGGING INTERVALS
------	----	----------------	------	----	--------------------

6 GROUT MATERIAL:	1	Neat cement	2	Cement grout	3	Bentonite	4	Other	
Grout Intervals: From	0	ft. to	15	ft.	From	15	ft. to	40	ft.

What is the nearest source of possible contamination:

1 Septic tank	4 Lateral lines	7 Pit privy	10 Livestock pens	14 Abandoned water well
2 Sewer lines	5 Cess pool	8 Sewage lagoon	11 Fuel storage	15 Oil well/Gas well
3 Watertight sewer lines	6 Seepage pit	9 Feedyard	12 Fertilizer storage	16 Other (specify below)

Direction from well?

How many feet?

FROM TO LITHOLOGIC LOG FROM TO PLUGGING INTERVALS

0 4 Clay, Dark Brown

4 6 Sand, Tan

6 27 Sand, Tan

27 43 Clay, Yellow to Brown

43 60 Gravel, Tan