USE TYPEWRITER OR BALL POINT PEN-PRESS FIRMLY, PRINT CLEARLY.

WATER WELL RECORD
KSA 82a-1201-1215

Kansas Department of Health and Environment-Division of Environment
(Water well Contractors)
Topeka, Kansas 66620

1. Location of well:	County	Fraction	Section number	Township number	Range number
	Barton	NE 1/4 NE 1/4 NE 1/4	2	T 19 S	R 14 E/W

2. Distance and direction from nearest town or city: 4 N 3 W of Great Bend
Street address of well location if in city:

3. Owner of well: Jerome Lang
R.R. or street: 302 E 3rd St.
City, state, zip code: Hoisington, Ks.

4. Locate with "X" in section below: Sketch map:

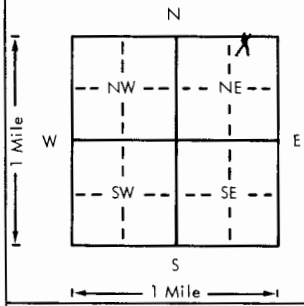

6. Bore hole dia. 24 in. Completion date 9-4-75
Well depth 112 ft.

7. __ Cable tool ✓ Rotary __ Driven __ Dug
__ Hollow rod __ Jetted __ Bored __ Reverse rotary

8. Use: __ Domestic __ Public supply __ Industry
✓ Irrigation __ Air conditioning __ Stock
__ Lawn __ Oil field water __ Other

9. Casing: Material Steel ✓ Height: Above or below
Threaded ___ Welded ✓ Surface 18 in.
RMP ___ PVC ___ Weight ___ lbs./ft.
Dia 16 in. to 112 ft. depth Wall Thickness: inches or
Dia. ___ in. to ___ ft. depth gage No. 7

5. Type and color of material	From	To
Top Soil	0	2
Dark Brown Clay	2	11
Lt. Brown Clay	11	45
Sand & Gravel clean loose med	45	66
Blue Gray & Brown Clay	66	72
Fine Sand	72	81
Sand & Gravel med loose clean	81	86
Sand & Gravel lot of Clay	86	90
Sand & Gravel clean Coarse loose	90	112
→ R.R. Blue Clay	112	115
(Use a second sheet if needed)		

10. Screen: Manufacturer's name Dowis
Type Steel Dia. 16
Slot/~~gauze~~ 3/16 Length 32
Set between 80 ft. and 112 ft.
___ ft. and ___ ft.
Gravel pack? ✓ Size range of material 1/2 3/4 3/8

11. Static water level: 46 ft. below land surface Date 7-31-75 (mo./day/yr.)

12. Pumping level below land surfaces:
30 ft. after 1 hrs. pumping 800 g.p.m.
___ ft. after ___ hrs. pumping ___ g.p.m.
Estimated maximum yield 900 g.p.m.

13. Water sample submitted: ___ Yes ___ No Date 8-19-75 (mo./day/yr.)

14. Well head completion:
___ Pitless adapter ___ Inches above grade

15. Well grouted? ✓
With: ___ Neat cement ___ Bentonite ✓ Concrete
Depth: From 6 ft. to 70 ft.

16. Nearest source of possible contamination:
ft. 900' Direction N Type Cattle
Well disinfected upon completion? ___ Yes ___ No

17. Pump: ___ Not installed
Manufacturer's name L-R
Model number 2CH 12 HP 30 Volts ___
Length of drop pipe 95 ft. capacity 900 g.p.m.
Type:
___ Submersible ✓ Turbine
___ Jet ___ Reciprocating
___ Centrifugal ___ Other

18. Elevation: 1854
Topography:
___ Hill
___ Slope
✓ Upland
___ Valley

19. Remarks: 24 S 4 C
19 14 2 NAM

20. Water well contractor's certification:
This well was drilled under my jurisdiction and this report is true to the best of my knowledge and belief.
Rosencrantz Bros
Business name License No.
Address Great Bend, Ks.
Signed ___ Date ___
Authorized representative

T 19 R 14 E/W Sec 2 1/4 NE 1/4 NE 1/4 NE 1/4

Forward the white, blue and pink copies to the Department of Health and Environment

Form WWC-5

MI-1023