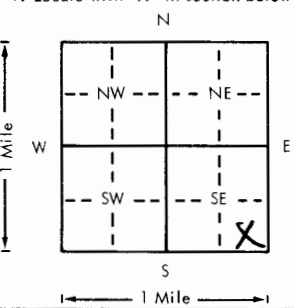


USE TYPEWRITER OR BALL
POINT PEN-PRESS FIRMLY,
PRINT CLEARLY.

WATER WELL RECORD
KSA 82a-1201-1215

Kansas Department of Health and
Environment-Division of Environment
(Water well Contractors)
Topeka, Kansas 66620

1. Location of well:		County Barton	Fraction SE 1/4 SE 1/4 SE 1/4	Section number 5	Township number T 19 S	Range number R 14 W
2. Distance and direction from nearest town or city: Street address of well location if in city:		1/8 S. HEIZER, KS		3. Owner of well: R.R. or street: City, state, zip code:		
				CORA THORN BURY HEIZER, KS		
4. Locate with "X" in section below:		Sketch map:		6. Bore hole dia. 8 in. Completion date 9-8-76 Well depth 50 ft.		
				7. ☐ Cable tool ☒ Rotary ☐ Driven ☐ Dug ☐ Hollow rod ☐ Jetted ☐ Bored ☐ Reverse rotary		
5. Type and color of material		From		To		8. Use: ☒ Domestic ☐ Public supply ☐ Industry ☐ Irrigation ☐ Air conditioning ☐ Stock ☐ Lawn ☐ Oil field water ☐ Other
Top Soil - clay		0		20		9. Casing: Material ☐ Height: above or below Threaded ☐ Welded ☐ Surface 12 in. RMP ☐ PVC ☒ Weight ☐ lbs./ft. Dia. 5 in. to 50 ft. depth Wall Thickness: inches or Dia. ☐ in. to ☐ ft. depth gage No. SEA 40
Sand		20		30		10. Screen: Manufacturer's name MPI Type PVC Dia. 5" Slot/gauze 1/8 Length 15' Set between 35 ft. and 50 ft. Gravel pack? ☒ Size range of material 18-34 ft.
Sand - Gravel		30		50		11. Static water level: 16 ft. below land surface Date 9-8-76 mo./day/yr.
11' ±						12. Pumping level below land surfaces: ____ ft. after ____ hrs. pumping ____ g.p.m. ____ ft. after ____ hrs. pumping ____ g.p.m. Estimated maximum yield 50 g.p.m.
						13. Water sample submitted: ____ mo./day/yr. ____ Yes ☒ No Date ____
						14. Well head completion: ____ Pitless adapter 12 inches above grade
						15. Well grouted? ☒ With: ☒ Neat cement ☐ Bentonite ☐ Concrete Depth: From 0 ft. to 10 ft.
						16. Nearest source of possible contamination: septic ft. 65 Direction N Type TANK Well disinfected upon completion? ☒ Yes ☐ No
						17. Pump: ☒ Not installed Manufacturer's name ____ Model number ____ HP ____ Volts ____ Length of drop pipe ____ ft. capacity ____ g.p.m. Type: ☐ Submersible ☐ Turbine ☐ Jet ☐ Reciprocating ☐ Centrifugal ☐ Other
18. Elevation:		19. Remarks:		20. Water well contractor's certification: This well was drilled under my jurisdiction and this report is true to the best of my knowledge and belief. Kelly S. Waterwell Service Business name R. A. Great Bend, KS License No. 949-14 Address Kelly P. P. Date 9-14-76 Signed Kelly P. P. Authorized representative		
Topography: ☐ Hill ☐ Slope ☐ Upland ☒ Valley						

Forward the white, blue and pink copies to the Department of Health and Environment

Form WWC-5