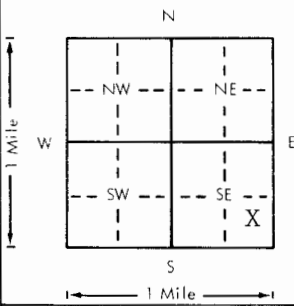


USE TYPEWRITER OR BALL
POINT PEN-PRESS FIRMLY,
PRINT CLEARLY.

WATER WELL RECORD
KSA 82a-1201-1215

Kansas Department of Health and
Environment-Division of Environment
(Water well Contractors)
Topeka, Kansas 66620

1. Location of well:		County Barton	Fraction 1/4 SE 1/4 SE 1/4	Section number 25	Township number T 19 S	Range number R 14 E
2. Distance and direction from nearest town or city: On West Edge of Great Bend, KS Street address of well location if in city:				3. Owner of well: Rural Housing Associates R.R. or street: Box 1513 City, state, zip code: Great Bend, KS 67530		
4. Locate with "X" in section below:  Sketch map:				6. Bore hole dia. 9 in. Completion date 11-28-78 Well depth 66 ft. Pump Set 12-5-78		
5. Type and color of material				7. ☐ Cable tool ☒ Rotary ☐ Driven ☐ Dug ☐ Hollow rod ☐ Jetted ☐ Bored ☐ Reverse rotary		
				8. Use: ☐ Domestic ☐ Public supply ☐ Industry ☐ Irrigation ☐ Air conditioning ☐ Stock ☒ Lawn ☐ Oil field water ☐ Other		
				9. Casing: Material Styrene Height: ☒ Above or below Threading: ☐ Welded ☒ Surface 12 in. RMP: ☐ PVC ☐ Weight 1.5 lbs./ft. Dia. 5 in. to 51 ft. depth Wall Thickness: inches or Dia. ☐ in. to ☐ ft. depth gage No. 200		
				10. Screen: Manufacturer's name Jess & Lowell Type Styrene 200 Dia. 5" Slot gauze 1/8" Length 15' Set between 51 ft. and 66 ft. Gravel pack? ☒ Yes Size range of material 3/8-200		
				11. Static water level: ☐ mo./day/yr. 18 ft. below land surface Date 11-28-78		
				12. Pumping level below land surfaces: Not Checked ____ ft. after ____ hrs. pumping ____ g.p.m. ____ ft. after ____ hrs. pumping ____ g.p.m. Estimated maximum yield ____ g.p.m.		
				13. Water sample submitted: ____ mo./day/yr. ☐ Yes ☒ No Date ____		
				14. Well head completion: ☐ Pitless adapter 12 inches above grade		
				15. Well grouted? ☒ Yes With: ☒ Neat cement ☐ Bentonite ☐ Concrete Depth: From 0 ft. to 10 ft.		
				16. Nearest source of possible contamination: FIELD ft. ____ Direction ____ Type ____ Well disinfected upon completion? ☒ Yes ☐ No		
(Use a second sheet if needed)				17. Pump: ☐ Not installed Manufacturer's name Berkeley Pump Co. Model number 4CM-15 HP 5 Volts 230 Length of drop pipe 43 ft. capacity 60 g.p.m. Type: ☒ Submersible ☐ Turbine ☐ Jet ☐ Reciprocating ☐ Centrifugal ☐ Other		
				20. Water well contractor's certification: This well was drilled under my jurisdiction and this report is true to the best of my knowledge and belief. Clarke Well & Eq., Inc. 185 Business name Great Bend, KS 67530 License No. 12-6-78 Address 12-6-78 Signed [Signature] Date 12-6-78 Authorized representative		
				18. Elevation:		
				19. Remarks:		
				Topography: ☐ Hill ☐ Slope ☐ Upland ☐ Valley		

Forward the white, blue and pink copies to the Department of Health and Environment

Form WWC-5