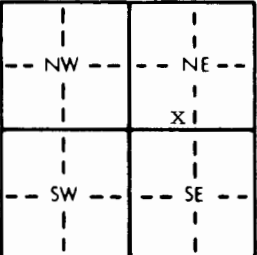
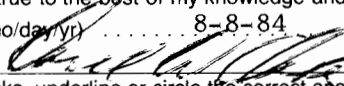


1 LOCATION OF WATER WELL:		Fraction	Section Number	Township Number	Range Number
County: Barton		SE 1/4 SW 1/4 NE 1/4	25	T 19 S	R 14 NW
Distance and direction from nearest town or city street address of well if located within city?					
5949 Aspen, Great Bend, KS					
2 WATER WELL OWNER: Allen Juergensen					
RR#, St. Address, Box # : 5949 Aspen			Board of Agriculture, Division of Water Resources		
City, State, ZIP Code : Great Bend, KS 67530			Application Number: not required		
3 LOCATE WELL'S LOCATION WITH AN "X" IN SECTION BOX:		4 DEPTH OF COMPLETED WELL: 43 ft. ELEVATION: unknown			
N W E S 		Depth(s) Groundwater Encountered 1. 18 ft. 2. ft. 3. ft.			
		WELL'S STATIC WATER LEVEL 18 ft. below land surface measured on mo/day/yr 7-30-84			
		Pump test data: Well water was not ck'd ft. after hours pumping gpm			
		Est. Yield unknown gpm: Well water was ft. after hours pumping gpm			
		Bore Hole Diameter 9 in. to 43 ft., and in. to ft.			
TYPE OF BLANK CASING USED:		CASING JOINTS: Glued XX Clamped			
1 Steel		5 Wrought iron	8 Concrete tile	Welded	
3 RMP (SR)		6 Asbestos-Cement	9 Other (specify below)	Threaded	
2 PVC		7 Fiberglass			
4 ABS					
Blank casing diameter 5 in. to 35 ft., Dia in. to ft., Dia in. to ft.					
Casing height above land surface 24 in., weight 2,277 lbs./ft. Wall thickness or gauge No. 214					
TYPE OF SCREEN OR PERFORATION MATERIAL:					
1 Steel					
3 Stainless steel					
5 Fiberglass					
8 RMP (SR)					
11 Other (specify)					
2 Brass					
4 Galvanized steel					
6 Concrete tile					
9 ABS					
12 None used (open hole)					
SCREEN OR PERFORATION OPENINGS ARE:					
1 Continuous slot					
3 Mill slot					
5 Gauzed wrapped					
8 Saw cut					
11 None (open hole)					
2 Louvered shutter					
4 Key punched					
6 Wire wrapped					
9 Drilled holes					
7 Torch cut					
10 Other (specify)					
SCREEN-PERFORATED INTERVALS: From 35 ft. to 43 ft., From ft. to ft.					
From ft. to ft., From ft. to ft.					
GRAVEL PACK INTERVALS: From 25 ft. to 43 ft., From ft. to ft.					
ANNULAR FILL From 10 ft. to 21 ft., From ft. to ft.					
6 GROUT MATERIAL: 1 Neat cement 2 Cement grout 3 Bentonite 4 Other					
Grout Intervals: From 0 ft. to 10 ft., From 21 ft. to 25 ft., From ft. to ft.					
What is the nearest source of possible contamination:					
1 Septic tank					
4 Lateral lines					
7 Pit privy					
10 Livestock pens					
14 Abandoned water well					
2 Sewer lines					
5 Cess pool					
8 Sewage lagoon					
11 Fuel storage					
15 Oil well/Gas well					
3 Watertight sewer lines					
6 Seepage pit					
9 Feedyard					
12 Fertilizer storage					
16 Other (specify below)					
13 Insecticide storage					
Direction from well? all How many feet? over 50'					
FROM	TO	LITHOLOGIC LOG	FROM	TO	LITHOLOGIC LOG
0	7	Topsoil & brown xxx clay			
7	11	Sand & gravel, med. clean			
11	14	Brown clay			
14	26	Sand & gravel, med. to coarse			
26	27	Brown clay			
27	28	Sand & gravel			
28	35	Yellow clay			
35	43	Sand & gravel, fine			
43		Yellow clay			
7 CONTRACTOR'S OR LANDOWNER'S CERTIFICATION: This water well was (1) constructed, (2) reconstructed, or (3) plugged under my jurisdiction and was completed on (mo/day/year) 7-30-84 and this record is true to the best of my knowledge and belief. Kansas Water Well Contractor's License No. C85 This Water Well Record was completed on (mo/day/yr) 8-8-84 under the business name of Clarke Well & Eq., Inc. by (signature) 					
INSTRUCTIONS: Use typewriter or ball point pen, PLEASE PRESS FIRMLY and PRINT clearly. Please fill in blanks, underline or circle the correct answers. Send top three copies to Kansas Department of Health and Environment, Division of Environment, Environmental Geology Section, Topeka, KS 66620. Send one to WATER WELL OWNER and retain one for your records.					