

HARRISON #1

WATER WELL RECORD Form WWC-5 KSA 82a-1212


1 LOCATION OF WATER WELL:	Fraction	Section Number	Township Number	Range Number
County: BARTON	SW 1/4 SE 1/4 NE 1/4	29	T 19 S	R 14 E

Distance and direction from nearest town or city street address of well if located within city?

GREAT BEND 4W 1/2 N WESTSIDE

2 WATER WELL OWNER:	Board of Agriculture, Division of Water Resources
RR#, St. Address, Box # : 221 S. BROADWAY SUITE 400	Application Number: 785-650
City, State, ZIP Code : WICHITA, KS. 67202	

3 LOCATE WELL'S LOCATION WITH AN "X" IN SECTION BOX:	4 DEPTH OF COMPLETED WELL: 85 ft. ELEVATION:
--	---

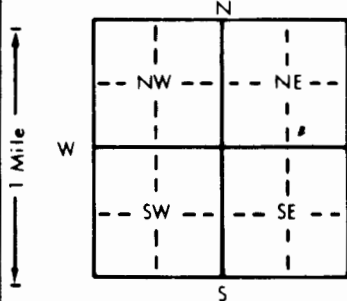

Depth(s) Groundwater Encountered 1. 29 ft. 2. 55 ft. 3. 55 ft.
WELL'S STATIC WATER LEVEL 27 ft. below land surface measured on mo/day/yr 7-10-85
Pump test data: Well water was — ft. after — hours pumping — gpm
Est. Yield — gpm: Well water was — ft. after — hours pumping — gpm
Bore Hole Diameter 7 7/8 in. to 85 ft. and — in. to — ft.
WELL WATER TO BE USED AS:
5 Public water supply 8 Air conditioning 11 Injection well
1 Domestic 3 Feedlot 6 Oil field water supply 9 Dewatering 12 Other (Specify below)
2 Irrigation 4 Industrial 7 Lawn and garden only 10 Observation well
Was a chemical/bacteriological sample submitted to Department? Yes — No — ; If yes, mo/day/yr sample was submitted —
Water Well Disinfected? Yes — No —

5 TYPE OF BLANK CASING USED:	5 Wrought iron	8 Concrete tile	CASING JOINTS: Glued XX Clamped —
1 Steel	3 RMP (SR)	6 Asbestos-Cement	9 Other (specify below)
2 PVC	4 ABS	7 Fiberglass	Welded —
Blank casing diameter 5 in. to 65 ft. Dia — in. to — ft. Dia — in. to — ft.			Threaded —

Casing height above land surface 12 in. weight 2-65 lbs./ft. Wall thickness or gauge No. 7-14
--

TYPE OF SCREEN OR PERFORATION MATERIAL:	7 PVC	10 Asbestos-cement
1 Steel	3 Stainless steel	5 Fiberglass
2 Brass	4 Galvanized steel	8 RMP (SR)
3 Mill slot	5 Fiberglass	9 ABS
4 Key punched	6 Concrete tile	11 Other (specify)
SCREEN OR PERFORATION OPENINGS ARE:	8 Saw cut	12 None used (open hole)

1 Continuous slot	3 Mill slot	5 Gauzed wrapped	8 Saw cut	11 None (open hole)
2 Louvered shutter	4 Key punched	6 Wire wrapped	9 Drilled holes	
7 Torch cut	10 Other (specify)			

SCREEN-PERFORATED INTERVALS:	From 65 ft. to 85 ft.	From — ft. to — ft.	From — ft. to — ft.
GRAVEL PACK INTERVALS:	From 55 ft. to 85 ft.	From — ft. to — ft.	From — ft. to — ft.

6 GROUT MATERIAL:	1 Neat cement	2 Cement grout	3 Bentonite	4 Other
Grout Intervals: From 0 ft. to 10 ft.	From — ft. to — ft.	From — ft. to — ft.	From — ft. to — ft.	From — ft. to — ft.

What is the nearest source of possible contamination: NONE	10 Livestock pens	14 Abandoned water well
1 Septic tank	4 Lateral lines	7 Pit privy
2 Sewer lines	5 Cess pool	8 Sewage lagoon
3 Watertight sewer lines	6 Seepage pit	9 Feedyard
		11 Fuel storage
		12 Fertilizer storage
		13 Insecticide storage
		15 Oil well/Gas well
		16 Other (specify below)

Direction from well?	How many feet?
----------------------	----------------

FROM	TO	LITHOLOGIC LOG	FROM	TO	LITHOLOGIC LOG
0	2	TOP SOIL			
2	10	CLAY			
10	25	SANDY CLAY			
25	43	GRAVEL			
43	55	CLAY			
55	83	GRAVEL			
83	85	CLAY			

7 CONTRACTOR'S OR LANDOWNER'S CERTIFICATION: This water well was (1) constructed, (2) reconstructed, or (3) plugged under my jurisdiction and was completed on (mo/day/year) 7-10-85 and this record is true to the best of my knowledge and belief. Kansas
--

Water Well Contractor's License No. 389 This Water Well Record was completed on (mo/day/yr) 7-15-85

under the business name of REISER WATER WELL SERV INC by (signature) Reiser

INSTRUCTIONS: Use typewriter or ball point pen, PLEASE PRESS FIRMLY and PRINT clearly. Please fill in blanks, underline or circle the correct answers. Send top three copies to Kansas Department of Health and Environment, Division of Environment, Environmental Geology Section, Topeka, KS 66620. Send one to WATER WELL OWNER and retain one for your records.