

1 LOCATION OF WATER WELL:	Fraction <u>1420 FSL 110 FWL</u>	Section Number <u>30</u>	Township Number <u>T 19 S</u>	Range Number <u>R 14 EW</u>
County: <u>BARTON</u>	<u>SW 1/4 NW 1/4 SW 1/4</u>			

Distance and direction from nearest town or city street address of well if located within city?

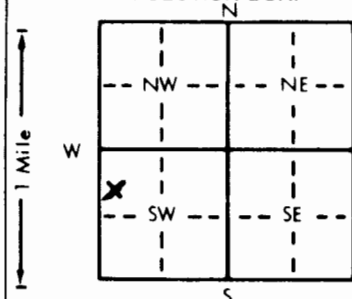
GREAT BEND 1/2 N 6 W 1/2 S EASTSIDE2 WATER WELL OWNER: TRACY GUTIERREZRR#, St. Address, Box #: 1438 BROADWAY

Board of Agriculture, Division of Water Resources

City, State, ZIP Code: GREAT BEND, KS 67530

Application Number:

3 LOCATE WELL'S LOCATION WITH AN "X" IN SECTION BOX:

4 DEPTH OF COMPLETED WELL: 130 ft. ELEVATION: 5 SALT IN WATERDepth(s) Groundwater Encountered 1. 65 ft. 2. 103 ft. 3. 104 ft.WELL'S STATIC WATER LEVEL 35 ft. below land surface measured on mo/day/yr 6-28-84Pump test data: Well water was 39 ft. after 2 hours pumping 30 gpmEst. Yield 30 gpm Well water was 39 ft. after 2 hours pumping 30 gpmBore Hole Diameter 7 7/8 in. to 130 ft., and 130 in. to 130 ft.

WELL WATER TO BE USED AS: 5 Public water supply 8 Air conditioning 11 Injection well

1 Domestic 3 Feedlot 6 Oil field water supply 9 Dewatering 12 Other (Specify below)

2 Irrigation 4 Industrial 7 Lawn and garden only 10 Observation well

Was a chemical/bacteriological sample submitted to Department? Yes No X If yes, mo/day/yr sample was submittedWater Well Disinfected? Yes No

5 TYPE OF BLANK CASING USED:

5 Wrought iron

8 Concrete tile

CASING JOINTS: Glued X Clamped

1 Steel 3 RMP (SR)

6 Asbestos-Cement

9 Other (specify below)

Welded

2 PVC 4 ABS

7 Fiberglass

Threaded

Blank casing diameter 5 in. to 116 ft. Dia. 116 in. to 116 ft. Dia. 116 in. to 116 ft.Casing height above land surface 12 in., weight 2.65 lbs./ft. Wall thickness or gauge No. 2 1/4

TYPE OF SCREEN OR PERFORATION MATERIAL:

1 Steel 3 Stainless steel

5 Fiberglass

7 PVC

10 Asbestos-cement

2 Brass 4 Galvanized steel

6 Concrete tile

8 RMP (SR)

11 Other (specify)

9 ABS

12 None used (open hole)

SCREEN OR PERFORATION OPENINGS ARE: 48

1 Continuous slot

3 Mill slot

5 Gauzed wrapped

8 Saw cut

11 None (open hole)

2 Louvered shutter

4 Key punched

6 Wire wrapped

9 Drilled holes

7 Torch cut

10 Other (specify)

SCREEN-PERFORATED INTERVALS: From 116 ft. to 130 ft., From 116 ft. to 130 ft., From 116 ft. to 130 ft.GRAVEL PACK INTERVALS: From 100 ft. to 130 ft., From 100 ft. to 130 ft., From 100 ft. to 130 ft.

6 GROUT MATERIAL:

1 Neat cement

2 Cement grout

3 Bentonite

4 Other

Grout intervals: From 100 ft. to 90 ft., From 13 ft. to 3 ft., From 13 ft. to 3 ft.What is the nearest source of possible contamination: NONE AT PRESENT

1 Septic tank

4 Lateral lines

7 Pit privy

10 Livestock pens

14 Abandoned water well

2 Sewer lines

5 Cess pool

8 Sewage lagoon

11 Fuel storage

15 Oil well/Gas well

3 Watertight sewer lines 6 Seepage pit

9 Feedyard

12 Fertilizer storage

16 Other (specify below)

13 Insecticide storage

Direction from well?

How many feet?

FROM	TO	LITHOLOGIC LOG	FROM	TO	LITHOLOGIC LOG
0	5	SOIL			
5	65	CLAY			
65	68	SAND			
68	85	SANDY CLAY			
85	103	CLAY			
103	130	SANDY CLAY & CLAY MIX - Dakota			

7 CONTRACTOR'S OR LANDOWNER'S CERTIFICATION: This water well was (1) constructed, (2) reconstructed, or (3) plugged under my jurisdiction and was completed on (mo/day/year) 6-29-84 and this record is true to the best of my knowledge and belief. KansasWater Well Contractor's License No. 389 This Water Well Record was completed on (mo/day/yr) 6-30-84under the business name of REISER WATER WELL SERV. INC. by (signature) Rudolph Reiser

INSTRUCTIONS: Use typewriter or ball point pen, PLEASE PRESS FIRMLY and PRINT clearly. Please fill in blanks, underline or circle the correct answers. Send top three copies to Kansas Department of Health and Environment, Division of Environment, Environmental Geology Section, Topeka, KS 66620. Send one to WATER WELL OWNER and retain one for your records.

DP

OFFICE USE ONLY

T

R

EW

SEC.

30

SW

NW

SW