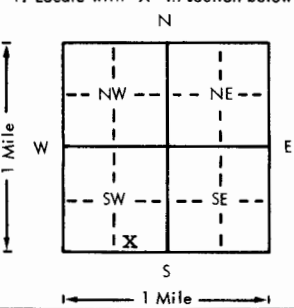


USE TYPEWRITER OR BALL
POINT PEN-PRESS FIRMLY,
PRINT CLEARLY.

WATER WELL RECORD
KSA 82a-1201-1215

Kansas Department of Health and
Environment-Division of Environment
(Water well Contractors)
Topeka, Kansas 66620

1. Location of well:		County Barton	Fraction SW 1/4 SE 1/4 SW 1/4	Section number 30	Township number T 19 S	Range number R 14 E
2. Distance and direction from nearest town or city: 6 mi. West of Great Bend, KS Street address of well location if in city:				3. Owner of well: Robert LeRoy R.R. or street: Route 4 City, state, zip code: Great Bend, KS 67530		
4. Locate with "X" in section below: 				Sketch map: SEE RECORD BELOW		
5. Type and color of material				From	To	
Top soil				0	3	
Brown clay				3	20	
Sand, gravel & clay clay streaks				20	25	
Sand & gravel				25	45	
Brown clay				45	55	
Sand & clay gravel				55	59	
Brown clay PR ≥ 57'				59	65	
=====						
CASING & SCREEN RECORD						
Plain casing				0	31	
Doerr screen -- Double-slot				31	41	
Johnson Division screen -- .125 Irrigator				41	46	
Plain casing				46	55	
Johnson Division screen -- .125 Irrigator				55	60	
Plain casing				60	65	
(Use a second sheet if needed)						
18. Elevation:		19. Remarks:		20. Water well contractor's certification: This well was drilled under my jurisdiction and this report is true to the best of my knowledge and belief. Clarke Well & Eq., Inc. 185 Business name License No. Address Great Bend, KS Signed [Signature] Date 10-22-75 Authorized representative		
Topography: ____ Hill ____ Slope ____ Upland ____ Valley						

Forward the white, blue and pink copies to the Department of Health and Environment

Form WWC-5