


Approx. 5 3/4 miles west of Great Bend, KS

Application Number: not required

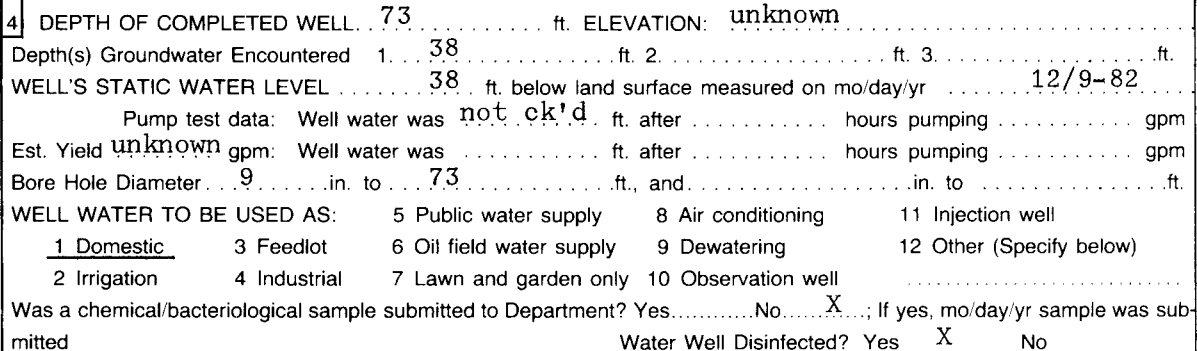

Direction from well? Southeast How many feet? 100'

INSTRUCTIONS: Use typewriter or ball point pen, PLEASE PRESS FIRMLY and PRINT clearly. Please fill in blanks, underline or circle the correct answers. Send top three copies to Kansas Department of Health and Environment, Division of Environment, Environmental Geology Section, Topeka, KS 66620. Send one to WATER WELL OWNER and retain one for your records.

OFFICE USE ONLY

19 T

R
14

SEC. 3C

$\frac{1}{4}$ lb $\frac{1}{4}$ lb $\frac{1}{4}$ lb