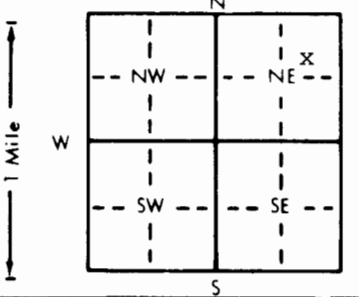


1 LOCATION OF WATER WELL:		Fraction	Section Number		Township Number	Range Number
County: Barton		$S\frac{1}{2}$ $\frac{1}{4}$ NE $\frac{1}{4}$ NE $\frac{1}{4}$	30		T 19 S	R 14 <u>EW</u>
Distance and direction from nearest town or city street address of well if located within city? Great Bend 5W 3/4 N W side						
2 WATER WELL OWNER: Raymond Waplehorst						
RR#, St. Address, Box # : RR4						
City, State, ZIP Code : Great Bend, Ks. 67530						
Board of Agriculture, Division of Water Resources						
Application Number:						
3 LOCATE WELL'S LOCATION WITH AN "X" IN SECTION BOX:		4 DEPTH OF COMPLETED WELL 75		ft. ELEVATION: Unknown		
		Depth(s) Groundwater Encountered 1. 37		ft. 2. . ft. 3. . ft.		
		WELL'S STATIC WATER LEVEL 37		ft. below land surface measured on mo/day/yr 9/6/89		
		Pump test data: Well water was		ft. after		hours pumping gpm
		Est. Yield 65		gpm: Well water was		ft. after hours pumping gpm
		Bore Hole Diameter 8		in. to 75		ft., and in. to ft.
		WELL WATER TO BE USED AS:		5 Public water supply		8 Air conditioning 11 Injection well
		1 Domestic		3 Feedlot		6 Oil field water supply 9 Dewatering 12 Other (Specify below)
		2 Irrigation		4 Industrial		7 Lawn and garden only 10 Monitoring well
		Was a chemical/bacteriological sample submitted to Department? Yes		No X		If yes, mo/day/yr sample was submitted
		Water Well Disinfected? Yes X		No		
5 TYPE OF BLANK CASING USED:						
1 Steel 3 RMP (SR) 5 Wrought iron 8 Concrete tile CASING JOINTS: Glued X Clamped						
2 PVC 4 ABS 6 Asbestos-Cement 9 Other (specify below) Welded						
7 Fiberglass Threaded						
Blank casing diameter 5 in. to 65 ft. Dia. in. to ft. Dia. in. to ft.						
Casing height above land surface 12 in. weight 2.8 lbs./ft. Wall thickness or gauge No. Sch. 40						
TYPE OF SCREEN OR PERFORATION MATERIAL:						
1 Steel 3 Stainless steel 5 Fiberglass 7 PVC 10 Asbestos-cement						
2 Brass 4 Galvanized steel 6 Concrete tile 8 RMP (SR) 11 Other (specify)						
9 ABS 12 None used (open hole)						
SCREEN OR PERFORATION OPENINGS ARE:						
1 Continuous slot 3 Mill slot 5 Gauzed wrapped 8 Saw cut 11 None (open hole)						
2 Louvered shutter 4 Key punched 6 Wire wrapped 9 Drilled holes						
7 Torch cut 10 Other (specify)						
SCREEN-PERFORATED INTERVALS: From 65 ft. to 75 ft. From ft. to ft. From ft. to ft. From ft. to ft.						
GRAVEL PACK INTERVALS: From 20 ft. to 75 ft. From ft. to ft. From ft. to ft. From ft. to ft.						
6 GROUT MATERIAL: 1 Neat cement 2 Cement grout 3 Bentonite 4 Other						
Grout Intervals: From 0 ft. to 20 ft. From ft. to ft. From ft. to ft. From ft. to ft.						
What is the nearest source of possible contamination:						
1 Septic tank 4 Lateral lines 7 Pit privy 10 Livestock pens 14 Abandoned water well						
2 Sewer lines 5 Cess pool 8 Sewage lagoon 11 Fuel storage 15 Oil well/Gas well						
3 Watertight sewer lines 6 Seepage pit 9 Feedyard 12 Fertilizer storage 16 Other (specify below)						
13 Insecticide storage						
Direction from well? Southwest						
How many feet? 350						
FROM		TO		LITHOLOGIC LOG		FROM TO PLUGGING INTERVALS
0		25		Top Soil & clay		
25		52		Sand & Gravel		
52		65		Clay		
65		75		Sand Gravel		
7 CONTRACTOR'S OR LANDOWNER'S CERTIFICATION: This water well was (1) constructed, (2) reconstructed, or (3) plugged under my jurisdiction and was completed on (mo/day/year) 9/6/89 and this record is true to the best of my knowledge and belief. Kansas Water Well Contractor's License No. 186 This Water Well Record was completed on (mo/day/yr) 10/16/89 under the business name of Kelly's Water Well by (signature) Kelly's Water Well						
INSTRUCTIONS: Use typewriter or ball point pen. PLEASE PRESS FIRMLY and PRINT clearly. Please fill in blanks, underline or circle the correct answers. Send top three copies to Kansas Department of Health and Environment, Bureau of Water Protection, Topeka, Kansas 66620-7320. Telephone: 913-296-5514. Send one to WATER WELL OWNER and retain one for your records.						