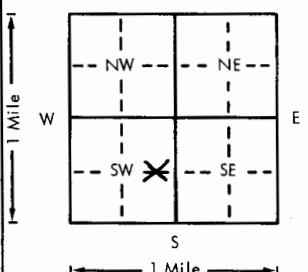


USE TYPEWRITER OR BALL
POINT PEN-PRESS FIRMLY,
PRINT CLEARLY.

WATER WELL RECORD
KSA 82a-1201-1215

Kansas Department of Health and
Environment-Division of Environment
(Water well Contractors)
Topeka, Kansas 66620

1. Location of well:		County <u>Barton</u>	Fraction <u>C 1/4 SW 1/4</u>	Section number <u>34</u>	Township number <u>T 19 S</u>	Range number <u>R 14 W E (W)</u>
2. Distance and direction from nearest town or city: <u>BEAD Die Base</u>			3. Owner of well: <u>C. F. O. Delgado</u> R.R. or street: <u>1107 Union National Bldg.</u> City, state, zip code: <u>Wichita, Kansas 67202</u>			
4. Locate with "X" in section below:		Sketch map:		6. Bore hole dia. <u>9</u> in. Completion date <u>12-26-78</u> Well depth <u>18</u> ft.		
				7. ☒ Cable tool ☒ Rotary ☐ Driven ☐ Dug ☐ Hollow rod ☐ Jetted ☐ Bored ☐ Reverse rotary		
5. Type and color of material				From	To	8. Use: ☐ Domestic ☐ Public supply ☐ Industry ☐ Irrigation ☐ Air conditioning ☐ Stock ☐ Lawn ☒ Oil field water ☐ Other
<u>Sandy Clay</u>				<u>0</u>	<u>18</u>	9. Casing: Material <u> </u> Height: Above or below <u>12</u> Threaded <u> </u> Welded ☒ Surface <u>278-3</u> in. RMP <u> </u> PVC ☒ Weight <u>278-3</u> lbs./ft. Dia. <u>5</u> in. to <u>20</u> ft. depth Wall Thickness: inches or Dia. <u> </u> in. to <u> </u> ft. depth gage No. <u>200</u>
<u>Clay</u>				<u>18</u>	<u>30</u>	10. Screen: Manufacturer's name <u>Coerless</u> Type <u>Saw</u> Dia. <u>5</u> Slot/gauze <u>1/8</u> Length <u>20</u> Set between <u>60</u> ft. and <u>40</u> ft. <u> </u> ft. and <u> </u> ft. Gravel pack <u>yes</u> Size range of material <u>1/8-1/4</u>
<u>Gravel</u>				<u>30</u>	<u>60</u>	11. Static water level: <u> </u> mo./day/yr. <u>18</u> ft. below land surface Date <u> </u>
<u>CLAY 2 30 ft</u>						12. Pumping level below land surfaces: <u> </u> ft. after <u> </u> hrs. pumping <u> </u> g.p.m. <u> </u> ft. after <u> </u> hrs. pumping <u> </u> g.p.m. Estimated maximum yield <u> </u> g.p.m.
						13. Water sample submitted: <u> </u> mo./day/yr. <u> </u> Yes ☒ No Date <u> </u>
						14. Well head completion: <u> </u> Pitless adapter <u>12</u> Inches above grade
						15. Well grouted? <u>yes</u> With: <u> </u> Neat cement ☒ Bentonite <u> </u> Concrete <u> </u> Depth: From <u>0</u> ft. to <u>10</u> ft.
						16. Nearest source of possible contamination: ft. <u> </u> Direction <u> </u> Type <u> </u> Well disinfected upon completion? <u> </u> Yes ☒ No
						17. Pump: <u> </u> Not installed Manufacturer's name <u> </u> Model number <u> </u> HP <u> </u> Volts <u> </u> Length of drop pipe <u> </u> ft. capacity <u> </u> g.p.m. Type: <u> </u> Submersible <u> </u> Turbine <u> </u> Jet <u> </u> Reciprocating <u> </u> Centrifugal <u> </u> Other
(Use a second sheet if needed)						
18. Elevation:		19. Remarks:		20. Water well contractor's certification: This well was drilled under my jurisdiction and this report is true to the best of my knowledge and belief <u>Myers Water Well 143</u> Business name <u>Great Bend</u> License No. <u> </u> Address <u> </u> Signed <u>David Insudall</u> Date <u>12-26-78</u> Authorized representative		
Topography: ☐ Hill ☒ Slope ☐ Upland ☐ Valley						