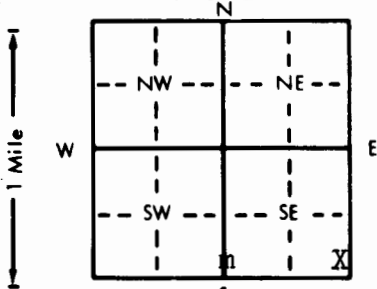


1 LOCATION OF WATER WELL: County: <u>Barton</u>		Fraction <u>SE</u> $\frac{1}{4}$ <u>SE</u> $\frac{1}{4}$ <u>SE</u> $\frac{1}{4}$		Section Number <u>35</u>	Township Number T <u>19</u> S	Range Number R <u>14</u> W E/W
Distance and direction from nearest town or city street address of well if located within city? <u>South edge of Great Bend, Kansas</u>						
2 WATER WELL OWNER: RR#, St. Address, Box # : City, State, ZIP Code		Steve Herron Route 1, Box 48 Great Bend, Kansas 67530				
		Board of Agriculture, Division of Water Resources Application Number: <u>None</u>				
3 LOCATE WELL'S LOCATION WITH AN "X" IN SECTION BOX: 		4 DEPTH OF COMPLETED WELL <u>97</u> ft. ELEVATION: <u>Unknown</u> Depth(s) Groundwater Encountered <u>1.10</u> ft. 2. <u>10</u> ft. 3. <u>12/30/81</u> ft. WELL'S STATIC WATER LEVEL <u>10</u> ft. below land surface measured on mo/day/yr Pump test data: Well water was <u>60</u> gpm. Well water was <u>8</u> ft. after <u>97</u> ft. and <u>12/30/81</u> ft. hours pumping <u>60</u> gpm. Bore Hole Diameter <u>8</u> in. to <u>97</u> ft. and <u>12/30/81</u> ft. hours pumping <u>60</u> gpm. WELL WATER TO BE USED AS: 1 <u>Domestic</u> 3 Feedlot 6 Oil field water supply 9 Dewatering 12 Other (Specify below) 2 Irrigation 4 Industrial 7 Lawn and garden only 10 Observation well Was a chemical/bacteriological sample submitted to Department? Yes <u>No</u> ; If yes, mo/day/yr sample was submitted <u>No</u> Water Well Disinfected? Yes <u>No</u>				
5 TYPE OF BLANK CASING USED: 1 Steel 3 RMP (SR) 5 Wrought iron 8 Concrete tile 2 <u>PVC</u> 4 ABS 6 Asbestos-Cement 9 Other (specify below) Blank casing diameter <u>5</u> in. to <u>77</u> ft. Dia <u>2.8</u> in. to <u>40</u> ft. Dia <u>40</u> in. to <u>40</u> ft. Casing height above land surface <u>12</u> in. weight <u>2.8</u> lbs./ft. Wall thickness or gauge No. <u>Sch. 40</u> TYPE OF SCREEN OR PERFORATION MATERIAL: 1 Steel 3 Stainless steel 5 Fiberglass 8 RMP (SR) 10 Asbestos-cement 2 Brass 4 Galvanized steel 6 Concrete tile 9 ABS 11 Other (specify) SCREEN OR PERFORATION OPENINGS ARE: 1 Continuous slot 3 Mill slot 5 Gauzed wrapped 8 <u>Saw cut</u> 11 None (open hole) 2 Louvered shutter 4 Key punched 6 Wire wrapped 9 Drilled holes SCREEN-PERFORATED INTERVALS: From <u>77</u> ft. to <u>97</u> ft. GRAVEL PACK INTERVALS: From <u>10</u> ft. to <u>97</u> ft. 
6 GROUT MATERIAL: 1 Neat cement 2 Cement grout 3 Bentonite 4 Other Grout Intervals: From <u>0</u> ft. to <u>10</u> ft. From <u>10</u> ft. to <u>150</u> ft. From <u>150</u> ft. to <u>150</u> ft. From <u>150</u> ft. to <u>150</u> ft. What is the nearest source of possible contamination: 1 <u>Septic tank</u> 4 Lateral lines 7 Pit privy 10 Livestock pens 14 Abandoned water well 2 Sewer lines 5 Cess pool 8 Sewage lagoon 11 Fuel storage 15 <u>Abandoned well</u> 3 Watertight sewer lines 6 Seepage pit 9 Feedyard 12 Fertilizer storage 16 Other (specify below) Direction from well? <u>South</u> How many feet? <u>150</u>						
FROM TO LITHOLOGIC LOG		FROM TO LITHOLOGIC LOG				
0	10	Clay				
10	45	Sand and Gravel				
45	60	Clay				
60	97	Sand and Gravel				
7 CONTRACTOR'S OR LANDOWNER'S CERTIFICATION: This water well was (1) <u>constructed</u> , (2) reconstructed, or (3) plugged under my jurisdiction and was completed on (mo/day/year) <u>12/30/81</u> and this record is true to the best of my knowledge and belief. Kansas Water Well Contractor's License No. <u>186</u> This Water Well Record was completed on (mo/day/yr) <u>1/26/82</u> under the business name of <u>Kellys Water Well Service</u> by (signature) <u>[Signature]</u>						
INSTRUCTIONS: Use typewriter or ball point pen, PLEASE PRESS FIRMLY and PRINT clearly. Please fill in blanks, underline or circle the correct answers. Send top three copies to Kansas Department of Health and Environment, Division of Environment, Environmental Geology Section, Topeka, KS 66620. Send one to WATER WELL OWNER and retain one for your records.						