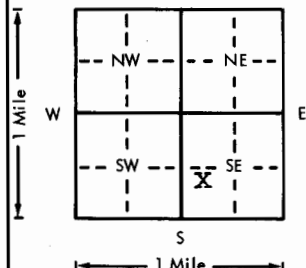


USE TYPEWRITER OR BALL
POINT PEN-PRESS FIRMLY,
PRINT CLEARLY.

WATER WELL RECORD
KSA 82a-1201-1215

Kansas Department of Health and
Environment-Division of Environment
(Water well Contractors)
Topeka, Kansas 66620

1. Location of well:	County Barton	Fraction nw 1/4 SW 1/4 SE 1/4	Section number 36	Township number T 19 S	Range number R 14W E/W
2. Distance and direction from nearest town or city: Street address of well location if in city: 1 SW Great Bend, Ks.			3. Owner of well: Randall Wagoner R.R. or street: R1 Great Bend, Ks. City, state, zip code:		
4. Locate with "X" in section below: Sketch map: 			6. Bore hole dia. 8 in. Completion date 12-23-77 Well depth 62 ft.		
5. Type and color of material			7. ☐ Cable tool ☒ Rotary ☐ Driven ☐ Dug ☐ Hollow rod ☐ Jetted ☐ Bored ☐ Reverse rotary		
			8. Use: ☒ Domestic ☐ Public supply ☐ Industry ☐ Irrigation ☐ Air conditioning ☐ Stock ☐ Lawn ☐ Oil field water ☐ Other		
			9. Casing: Material ☐ Height: Above ☒ XXXX Threaded ☐ Welded ☐ Surface 12 in. RMP ☐ PVC ☒ Weight 2.8 lbs./ft. Dia. 5 in. to 62 ft. depth Wall Thickness: inches or Dia. ☐ in. to ☐ ft. depth gage No. sch 40		
			10. Screen: Manufacturer's name Jetstream Type pvc Dia. 5" Slot/gauze 1/32" Length 20 Set between 42 ft. and 62 ft. Gravel pack? ☒ Size range of material 1/8-3/4"		
			11. Static water level: 14 ft. below land surface Date 12-23-77 12. Pumping level below land surfaces: ft. after ☐ hrs. pumping ☐ g.p.m. ft. after ☐ hrs. pumping ☐ g.p.m. Estimated maximum yield 50 g.p.m. 13. Water sample submitted: ☐ Yes ☒ No Date ☐		
14. Well head completion: ☒ Pitless adapter ☐ Inches above grade			15. Well grouted? ☒ With: ☒ Neat cement ☐ Bentonite ☐ Concrete Depth: From 0 ft. to 10 ft.		
16. Nearest source of possible contamination: ft. 50 Direction S Type Sewer Well disinfected upon completion? ☒ Yes ☐ No			17. Pump: ☐ Not installed Manufacturer's name Goulds Model number 13em HP 3/4 Volts 230 Length of drop pipe 30 ft. capacity 15 g.p.m. Type: ☒ Submersible ☐ Turbine ☐ Jet ☐ Reciprocating ☐ Centrifugal ☐ Other		
18. Elevation: Topography: ☐ Hill ☐ Slope ☐ Upland ☒ Valley			19. Remarks: 1865		
			20. Water well contractor's certification: This well was drilled under my jurisdiction and this report is true to the best of my knowledge and belief. Kellys Waterwell Ser 186 Business name R2 Great Bend# Ks. License No. Address Kellys Date 8-22 Signed Kellys Authorized representative		