


1 LOCATION OF WATER WELL: County: Barton	Fraction NE ¼ NE ¼ SW ¼	Section Number 36	Township Number T 19 S	Range Number R 14 E/W
---	----------------------------	----------------------	---------------------------	--------------------------

West edge Great Bend			
2	WATER WELL OWNER:	Nowak Const.	David Essmiller
	RR#, St. Address, Box # :	Box 9632	RR1 Box 82
	City, State, ZIP Code :	Wichita, Ks 67277	Geart Bend, Ks. 67530
			Board of Agriculture, Division of Water Resources
			Application Number:

4 DEPTH OF COMPLETED WELL... 2.5 ft. ELEVATION: ... Unknown

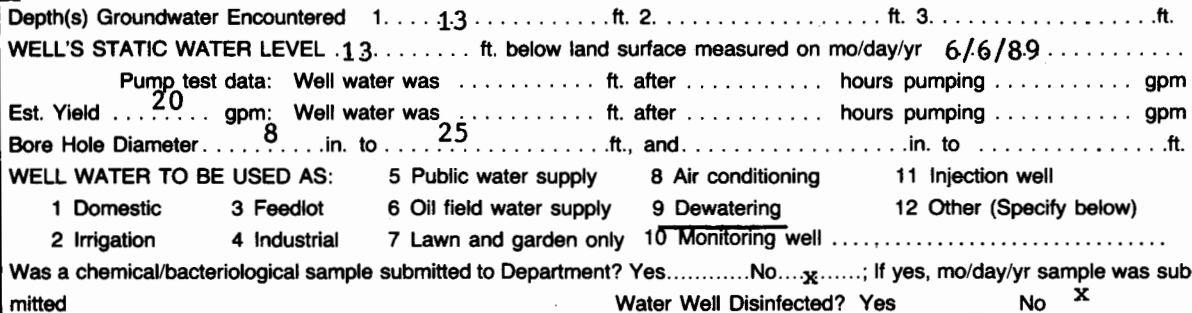

Blank casing diameter 5 in. to 15 ft. Dia. in. to ft. Dia. in. to ft.
Casing height above land surface 12 in., weight 2.8 lbs./ft. Wall thickness or gauge No. Sch. 40

SCREEN OR PERFORATION OPENINGS ARE:		5 Gauzed wrapped	8 <u>Saw cut</u>	11 None (open hole)
1 Continuous slot	3 Mill slot	6 Wire wrapped	9 Drilled holes	
2 Louvered shutter	4 Key punched	7 Torch cut	10 Other (specify)	

SCREEN-PERFORATED INTERVALS:	From . . . 15 ft. to . . . 25 ft.,	From ft. to ft.
	From ft. to ft.,	From ft. to ft.
GRAVEL PACK INTERVALS:	From . . . 10 ft. to . . . 25 ft.,	From ft. to ft.
	From ft. to ft.,	From ft. to ft.

6 GROUT MATERIAL: 1 Neat cement 2 Cement grout 3 Bentonite 4 Other

Grout Intervals: From 0 ft. to 10 ft. From ft. to ft. From ft. to ft.

What is the nearest source of possible contamination:

1 Septic tank	4 Lateral lines	7 Pit privy	10 Livestock pens	14 Abandoned water well
2 Sewer lines	5 Cess pool	8 Sewage lagoon	11 Fuel storage	15 Oil well/Gas well
3 Watertight sewer lines	6 Seepage pit	9 Feedyard	12 Fertilizer storage	16 Other (specify below)
Direction from well? South			13 Insecticide storage	
			How many feet? 1500	

[illegible]

7 CONTRACTOR'S OR LANDOWNER'S CERTIFICATION: This water well was (1) constructed, (2) reconstructed, or (3) plugged under my jurisdiction and was completed on (mo/day/year) 6/6/89 and this record is true to the best of my knowledge and belief. Kansas Water Well Contractor's License No. 186 This Water Well Record was completed on (mo/day/yr) 8/12/89 under the business name of Kell's Water Well by (signature) [Signature]