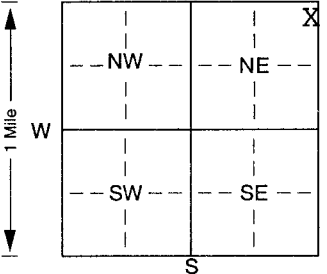


1 LOCATION OF WATER WELL: County: <u>Barton</u>		Fraction <u>NE</u> $\frac{1}{4}$ <u>NE</u> $\frac{1}{4}$ <u>NE</u> $\frac{1}{4}$		Section Number <u>29</u>	Township Number <u>T 19</u> <u>S</u>	Range Number <u>R 14w</u> <u>EW</u>
Distance and direction from nearest town or city street address of well if located within city? <u>4W, 1N of Great Bend, Ks.</u>						
2 WATER WELL OWNER: <u>James Aldrich</u> <u>Sterling Drilling Company</u> <u>Aldrich Lease</u> RR#, St. Address, Box # : <u>316 Forward St.</u> <u>P. O. Box 1006</u> Board of Agriculture, Division of Water Resources City, State, ZIP Code : <u>La Jolla, CA 92037</u> <u>Pratt, Ks. 67124</u> Application Number:						
3 LOCATE WELL'S LOCATION WITH AN "X" IN SECTION BOX: 		4 DEPTH OF COMPLETED WELL: <u>65</u> ft. ELEVATION: <u>unknown</u> Depth(s) Groundwater Encountered 1. <u>30</u> ft. 2. <u> </u> ft. 3. <u> </u> ft. WELL'S STATIC WATER LEVEL <u>30</u> ft. below land surface measured on mo/day/yr <u>10/17/01</u> Pump test data: Well water was <u> </u> ft. after <u> </u> hours pumping <u> </u> gpm Est. Yield <u> </u> gpm: Well water was <u> </u> ft. after <u> </u> hours pumping <u> </u> gpm Bore Hole Diameter <u>8</u> in. to <u>85</u> ft., and <u> </u> in. to <u> </u> ft. WELL WATER WAS USED AS: 5 Public water supply 8 Air conditioning 11 Injection well 1 Domestic 3 Feedlot 6 Oil field water supply 9 Dewatering 12 Other (Specify below) 2 Irrigation 4 Industrial 7 Domestic (lawn & garden) 10 Monitoring well <u> </u> Was a chemical/bacteriological sample submitted to Department? Yes. <u> </u> No <u> </u> ; If yes, mo/day/yr sample was submitted Water Well Disinfected? Yes <u> </u> No <u> </u>				
5 TYPE OF BLANK CASING USED: 1 Steel 3 RMP (SR) 5 Wrought iron 8 Concrete tile CASING JOINTS: Glued. <u> </u> Clamped. <u> </u> 2 PVC 4 ABS 6 Asbestos-Cement 9 Other (specify below) Welded <u> </u> 7 Fiberglass <u> </u> Threaded <u> </u> Blank casing diameter <u>5</u> in. to <u>25</u> ft., Dia <u> </u> in. to <u> </u> ft., Dia <u> </u> in. to <u> </u> ft. Casing height above land surface <u>3 ft. below</u> in., weight <u> </u> lbs./ft. Wall thickness or gauge No. <u> </u> TYPE OF SCREEN OR PERFORATION MATERIAL: <u>7 PVC</u> 10 Asbestos-cement 1 Steel 3 Stainless steel 5 Fiberglass 8 RMP (SR) 11 Other (specify) <u> </u> 2 Brass 4 Galvanized steel 6 Concrete tile 9 ABS 12 None used (open hole) SCREEN OR PERFORATION OPENINGS ARE: 5 Gauzed wrapped 8 Saw cut 11 None (open hole) 1 Continuous slot 3 Mill slot 6 Wire wrapped 9 Drilled holes 2 Louvered shutter 4 Key punched 7 Torch cut 10 Other (specify) <u> </u> ft. SCREEN-PERFORATED INTERVALS: From <u>25</u> ft. to <u>65</u> ft., From <u> </u> ft. to <u> </u> ft. From <u> </u> ft. to <u> </u> ft., From <u> </u> ft. to <u> </u> ft. GRAVEL PACK INTERVALS: From <u>20</u> ft. to <u>65</u> ft., From <u> </u> ft. to <u> </u> ft. From <u> </u> ft. to <u> </u> ft., From <u> </u> ft. to <u> </u> ft.						
6 GROUT MATERIAL: 1 Neat cement 2 Cement grout 3 Bentonite 4 Other <u> </u> Grout Intervals: From <u>3</u> ft. to <u>30</u> ft., From <u> </u> ft. to <u> </u> ft., From <u> </u> ft. to <u> </u> ft. What is the nearest source of possible contamination: 1 Septic tank 4 Lateral lines 7 Pit privy 10 Livestock pens 14 Abandoned water well 2 Sewer lines 5 Cess pool 8 Sewage lagoon 11 Fuel storage 15 Oil well/Gas well 3 Watertight sewer lines 6 Seepage pit 9 Feedyard 12 Fertilizer storage 16 Other (specify below) <u> </u> 13 Insecticide storage <u> </u> Direction from well? <u> </u> How many feet? <u> </u>						
FROM	TO	LITHOLOGIC LOG	FROM	TO	PLUGGING INTERVALS	
			<u>65</u>	<u>30</u>	<u>sand and gravel</u>	
			<u>30</u>	<u>3</u>	<u>bentonite</u>	
			<u>3</u>	<u>0</u>	<u>top soil</u>	
7 CONTRACTOR'S OR LANDOWNER'S CERTIFICATION: This water well was (1) constructed, (2) reconstructed, or (3) plugged under my jurisdiction and was completed on (mo/day/year) <u>10/17/01</u> and this record is true to the best of my knowledge and belief. Kansas Water Well Contractor's Licence No. <u>186</u> This Water Well Record was completed on (mo/day/yr) <u>10/22/01</u> under the business name of <u>Kelly's Water Well Service, Inc.</u> by (signature) <u>Kathryn A Good</u>						