WATER WELL RECORD Form WWC-5 KSA 82a-1212 ID No. _____

| 1 LOCATION OF WATER WELL: County: Barton | Fraction: C ¼ NW ¼ NE ¼ | Section Number: 29 | Township Number: T 19 S | Range Number: R 14W E/W |
|---|---|---|---|---|

Distance and direction from nearest town or city street address of well if located within city?
6 1/2W of Great Bend, Ks.

2 WATER WELL OWNER: James Aldrich Sterling Drilling Company Aldrich #3
RR#, St. Address, Box # : 316 Forward St. P. O. Box 1006
City, State, ZIP Code : LaJolla, CA 92037 Pratt, Ks. 67124
Board of Agriculture, Division of Water Resources Application Number:

3 LOCATE WELL'S LOCATION WITH AN "X" IN SECTION BOX:

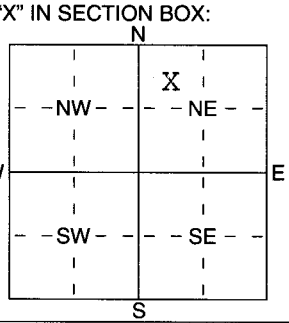


4 DEPTH OF COMPLETED WELL 68 ft. ELEVATION: unknown
Depth(s) Groundwater Encountered 1 38 ft. 2 ____ ft. 3 ____ ft.
WELL'S STATIC WATER LEVEL 38 ft. below land surface measured on mo/day/yr 02/24/04
Pump test data: Well water was ____ ft. after ____ hours pumping ____ gpm
Est. Yield 60 gpm: Well water was ____ ft. after ____ hours pumping ____ gpm
WELL WATER ~~TO BE~~ WAS USED AS: 5 Public water supply 8 Air conditioning 11 Injection well
1 Domestic 3 Feedlot 6 Oil field water supply 9 Dewatering 12 Other (Specify below)
2 Irrigation 4 Industrial 7 Domestic (lawn & garden) 10 Monitoring well

Was a chemical/bacteriological sample submitted to Department? Yes ____ No ____; If yes, mo/day/yrs sample was submitted
Water Well Disinfected? Yes ____ No

5 TYPE OF BLANK CASING USED:
1 Steel 3 RMP (SR) 5 Wrought iron 8 Concrete tile CASING JOINTS: Glued ____ Clamped ____
2 PVC 4 ABS 6 Asbestos-Cement 9 Other (specify below) Welded ____
7 Fiberglass Threaded ____
Blank casing diameter 5 in. to 48 ft., Dia ____ in. to ____ ft., Dia ____ in. to ____ ft.
Casing height above land surface 3 ft. below in., weight ____ lbs./ft. Wall thickness or guage No. ____

TYPE OF SCREEN OR PERFORATION MATERIAL:
1 Steel 3 Stainless Steel 5 Fiberglass 7 PVC 10 Asbestos-Cement
2 Brass 4 Galvanized Steel 6 Concrete tile 8 RMP (SR) 11 Other (Specify) ____
9 ABS 12 None used (open hole)

SCREEN OR PERFORATION OPENINGS ARE:
1 Continuous slot 3 Mill slot 5 Guazed wrapped 8 Saw cut 11 None (open hole)
2 Louvered shutter 4 Key punched 6 Wire wrapped 9 Drilled holes
7 Torch cut 10 Other (specify) ____ ft.

SCREEN-PERFORATED INTERVALS: From 48 ft. to 68 ft., From ____ ft. to ____ ft.
From ____ ft. to ____ ft., From ____ ft. to ____ ft.
GRAVEL PACK INTERVALS: From 20 ft. to 68 ft., From ____ ft. to ____ ft.
From ____ ft. to ____ ft., From ____ ft. to ____ ft.

6 GROUT MATERIAL: 1 Neat cement 2 Cement grout 3 Bentonite 4 Other ____
Grout Intervals: From 3 ft. to 23 ft., From 33 ft. to 38 ft., From ____ ft. to ____ ft.
What is the nearest source of possible contamination:
1 Septic tank 4 Lateral lines 7 Pit privy 10 Livestock pens 14 Abandoned water well
2 Sewer lines 5 Cess pool 8 Sewage lagoon 11 Fuel storage 15 Oil well/Gas well
3 Watertight sewer lines 6 Seepage pit 9 Feedyard 12 Fertilizer storage 16 Other (specify below)
13 Insecticide storage
Direction from well? How many feet?

| FROM | TO | LITHOLOGIC LOG | FROM | TO | PLUGGING INTERVALS |
|---|---|---|---|---|---|
| | | | 68 | 38 | sand and gravel |
| | | | 38 | 33 | bentonite |
| | | | 33 | 23 | compacked clay |
| | | | 23 | 3 | bentonite |
| | | | 3 | 0 | top soil |

7 CONTRACTOR'S OR LANDOWNER'S CERTIFICATION: This water well was (1) constructed, (2) reconstructed, or (3) plugged under my jurisdiction and was completed on (mo/day/year) 02/24/04 and this record is true to the best of my knowledge and belief. Kansas Water Well Contractor's Licence No 186 This Water Well Record was completed on (mo/day/yr) 02/28/04
under the business name of Kelly's Water Well Service, Inc. by (signature) Kathryn L Grad

INSTRUCTIONS: Use typewriter or ball point pen. *PLEASE PRESS FIRMLY* and *PRINT* clearly. Please fill in blanks, underline or circle the correct answers. Send top three copies to Kansas Department of Health and Environment, Bureau of Water, Geology Section, 1000 SW Jackson St., Suite 420, Topeka, Kansas 66612-1367. Telephone 785-296-5522. Send one to WATER WELL OWNER and retain one for your records. Fee of $5.00 for each constructed well.