258 8012 WATER WELL PLUGGING RECORD Form WWC-5P KSA82a-1212 ID NO. MW-16-D

| 1 LOCATION OF WATER WELL: | Fraction | Section Number | Township Number | Range Number |
|---|---|---|---|---|
| County: Barton | SW 1/4 NE 1/4 NE 1/4 | 34 | T 19 S | R 14 E (W) |

Distance and direction from nearest town or city street address of well if located within city?
Approximately 1 3/4 miles west and 1/4 mile south of Great Bend

2 WATER WELL OWNER: The Fuller Brush Company
RR#, St. Address, Box # P.O. Box 729 - One Fuller Way
City, State, ZIP Code Great Bend, KS 67530
Board of Agriculture, Division of Water Resources Application Number:

3 MARK WELL'S LOCATION WITH AN "X" IN SECTION BOX:

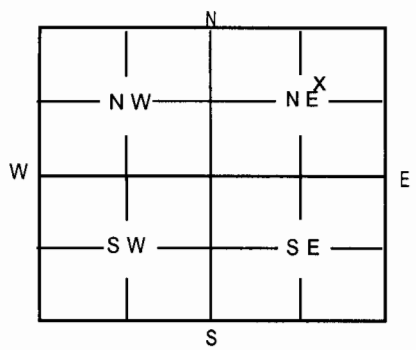


4 DEPTH OF WELL 64.8 ft
WELL'S STATIC WATER LEVEL 16.1 ft.
WELL WAS USED AS:

| | | |
|---|---|---|
| 1 Domestic | 5 Public Water Supply | 9 Dewatering |
| 2 Irrigation | 6 Oil Field Water Supply | (10 Monitoring Well) |
| 3 Feedlot | 7 Domestic (Lawn & Garden) | 11 Injection Well |
| 4 Industrial | 8 Air Conditioning | 12 Other |

Was a chemical / bacteriological sample submitted to Department? Yes ____ No ✓
If yes, mo/day/yr sample was submitted ____
Water Well Disinfected: Yes ✓ No ____

5 TYPE OF BLANK CASING USED:

| | | | | |
|---|---|---|---|---|
| 1 Steel | 3 RMP (SR) | 5 Wrought | 7 Fiberglass | 9 Other (Specify below) |
| (2 PVC) | 4 ABS | 6 Asbestos-Cement | 8 Concrete Tile | |

Blank casing diameter 2 in. Was casing pulled? Yes ____ No ✓ If yes, how much ____
Casing height above or (below) land surface 36 in.

6 GROUT PLUG MATERIAL: 1 Neat Cement 2 Cement grout 3 Bentonite 4 Other Bentonite Holeplug
Grout Plug Intervals: From ____ ft. to ____ ft., From ____ ft. to ____ ft. From 64.8 ft. to 0 ft.
What is the nearest source of possible contamination:

| | | | |
|---|---|---|---|
| 1 Septic tank | 6 Seepage pit | 11 Fuel storage | 16 Other (specify below) |
| 2 Sewer lines | 7 Pit privy | 12 Fertilizer storage | |
| 3 Watertight sewer lines | 8 Sewage lagoon | 13 Insecticide storage | None known |
| 4 Lateral lines | 9 Feedyard | 14 Abandoned water well | |
| 5 Cess Pool | 10 Livestock pens | 15 Oil well/Gas well | |

Direction from well? ____ How many feet? ____

| FROM | TO | PLUGGING MATERIALS |
|---|---|---|
| 64.8 | 0 | Bentonite Holeplug |
| | | |
| | | |
| | | |
| | | |
| | | |
| | | |

7 CONTRACTOR'S OR LANDOWNER'S CERTIFICATION: This water well was plugged under my jurisdiction and was completed on (mo/day/year) 10-14-05 and this record is true to the best of my knowledge and belief. Kansas Water Well Contractor's License No. 185 This Water Well Record was completed on (mo/day/year) 10-19-05 under the business name of Clarke Well & Equipment, Inc.
by (signature) George W Clark

INSTRUCTIONS: Use typewriter or ball point pen. Please press firmly and print clearly. Please fill in blanks, underline or circle the correct answers. Send top three copies to Kansas Department of Health & Environment, Bureau of Water, Topeka, Kansas 66620-0001. Telephone: 785/296-3565. Send one to Water Well Owner and retain one for your records.