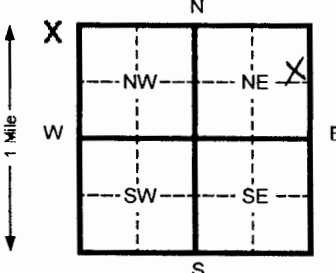


1 LOCATION OF WATER WELL:		Fraction	Section Number		Township Number	Range Number
County: Barton		SE 1/4 NE 1/4 NE 1/4	36		T 19 S	R 14
Distance and direction from nearest town or city street address of well if located within city?						
2 WATER WELL OWNER: Baker Petrolite Corporation						
RR#, St. Address, Box #: 5801 West 10th Str				Board of Agriculture, Division of Water Resources		
City, State, ZIP Code: Great Bend, KS 67530				Application Number:		
3 LOCATE WELL'S LOCATION WITH AN "X" IN SECTION BOX:		4 DEPTH OF COMPLETED WELL 15 ft. ELEVATION:				
		Depth(s) Groundwater Encountered 1 ft. 2 ft. 3 ft.				
		WELL'S STATIC WATER LEVEL ft. below land surface measured on mo/day/yr				
		Pump test data: Well water was ft. after hours pumping				
		Est. Yield gpm: Well water was ft. after hours pumping				
		Bore Hole Diameter 8 in. to 15 ft. and in. to				
		WELL WATER TO BE USED AS: 5 Public water supply 8 Air conditioning 11 Injection well				
		1 Domestic 3 Feed lot 6 Oil field water supply 9 Dewatering 12 Other (Specify below)				
		2 Irrigation 4 Industrial 7 Lawn and garden (domestic) 10 Monitoring well Vaper Extract				
		Was a chemical/bacteriological sample submitted to Department? Yes No X If yes, mo/day/yr sample w				
		submitted Water Well Disinfected? Yes No X				
5 TYPE OF BLANK CASING USED:						
1 Steel 3 RMP (SR) 5 Wrought Iron 8 Concrete tile CASING JOINTS: Glued Clamped						
2 PVC 4 ABS 6 Asbestos-Cement 9 Other (specify below) Welded						
7 Fiberglass Threaded X						
Blank casing diameter 4 in. to 10 ft., Dia in. to ft., Dia in. to						
Casing height above land surface 0 in., weight 2.071 lbs./ft. Wall thickness or gauge No. .237						
TYPE OF SCREEN OR PERFORATION MATERIAL:						
1 Steel 3 Stainless steel 5 Fiberglass 7 PVC 10 Asbestos-cement						
2 Brass 4 Galvanized steel 6 Concrete tile 8 RMP (SR) 11 Other (specify)						
SCREEN OR PERFORATION OPENINGS ARE:						
1 Continuous slot 3 Mill slot 5 Gauzed wrapped 8 Saw cut 11 None (open hole)						
2 Louvered shutter 4 Key punched 6 Wire wrapped 9 Drilled holes						
7 Torch cut 10 Other (specify)						
SCREEN-PERFORATED INTERVALS: From 10 ft. to 15 ft. From ft. to						
GRAVEL PACK INTERVALS: From 8 ft. to 15 ft. From ft. to						
6 GROUT MATERIAL: 1 Neat cement 2 Cement grout 3 Bentonite 4 Other						
Grout Intervals From 0 ft. to 8 ft. From ft. to ft. From ft. to						
What is the nearest source of possible contamination:						
1 Septic tank 4 Lateral lines 7 Pit privy 10 Livestock pens 14 Abandoned water well						
2 Sewer lines 5 Cess pool 8 Sewage lagoon 11 Fuel storage 15 Oil well/ Gas well						
3 Watertight sewer lines 6 Seepage pit 9 Feedyard 12 Fertilizer storage 16 Other (specify below)						
13 Insecticide storage Contaminated Site						
Direction from well? How many feet?						
FROM	TO	CODE	LITHOLOGIC LOG	FROM	TO	PLUGGING INTERVALS
0	1		Asphalt			
1	2		Clayey with Fine to Medium			
			Coarse Sand, Few Fine Gravel			
2	3		Fine to Medium Sandy Lean Cly			
3	6		Graded Fine to Med Sand Few			
			Silt			
6	14		Poorly Graded Fine, Med to			
			Coarse Sand with Fine Gravel			
14	15		Well-Graded Med to Coarse			
			Sand w/ Fine Gravel			
7 CONTRACTOR'S OR LANDOWNER'S CERTIFICATION: This water well was (1) constructed, (2) reconstructed, or (3) plugged under my jurisdiction and w						
completed on (mo/day/yr) 12-20-05 and this record is true to the best of my knowledge and belief. Kansas						
Water Well Contractor's License No. 554				This Water Well Record was completed on (mo/day/yr) 3-22-06		
under the business name of Woofter Pump & Well Inc.				by (signature) Gayle Woofter		
INSTRUCTIONS: Please fill in blanks and circle the correct answers. Send three copies to Kansas Department of Health and Environment, Bureau of Water, 1000 S						
Jackson St., Ste. 420, Topeka, Kansas 66612-1367. Telephone: 913-296-5545. Send one to WATER WELL OWNER and retain one for your records.						