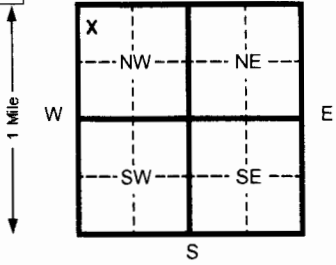


1 LOCATION OF WATER WELL:		Fraction	Section Number	Township Number	Range Number	
County: Barton		NW ¼ NW ¼ NW ¼	15	T 19 S	R 14 W	
Distance and direction from nearest town or city street address of well if located within city? 20' W of East Fence, 200' S of North Fence – 1.5 mi. SE of Hiezer on Hwy. 96						
2 WATER WELL OWNER: Darling International						
RR#, St. Address, Box # : 251 O'Conner Ridge Blvd., Ste. 300			Board of Agriculture, Division of Water Resources			
City, State, ZIP Code : Irving, TX 65038			Application Number:			
3 LOCATE WELL'S LOCATION WITH AN "X" IN SECTION BOX:		4 DEPTH OF COMPLETED WELL 30 ft. ELEVATION: 62.45 (TOC)				
		Depth(s) Groundwater Encountered 1 18.6 ft. 2 ft. 3 ft.				
		WELL'S STATIC WATER LEVEL 21.30 ft. below TOC measured on mo/day/yr 12/04/08				
		Pump test data: Well water was ft. after hours pumping gpm				
		Est. Yield gpm: Well water was ft. after hours pumping gpm				
		Bore Hole Diameter 8 in. to 30 ft. and in. to in. to in. to				
		WELL WATER TO BE USED AS: 5 Public water supply 8 Air conditioning 11 Injection well				
		1 Domestic 3 Feed lot 6 Oil field water supply 9 Dewatering 12 Other (Specify below)				
		2 Irrigation 4 Industrial 7 Lawn and garden (domestic) 10 Monitoring well				
		Was a chemical/bacteriological sample submitted to Department? Yes No X If yes, mo/day/yr sample was submitted				
		Water Well Disinfected? Yes No X				
5 TYPE OF BLANK CASING USED:						
1 Steel 3 RMP (SR) 5 Wrought Iron 8 Concrete tile CASING JOINTS: Glued Clamped						
2 PVC 4 ABS 6 Asbestos-Cement 9 Other (specify below) Welded						
Blank casing diameter 2 in. to 20 ft. Dia in. to ft. Dia in. to ft. Dia						
Casing height above land surface 36 in., weight 0.703 lbs./ft. Wall thickness or gauge No. SCH. 40						
TYPE OF SCREEN OR PERFORATION MATERIAL:						
1 Steel 3 Stainless steel 5 Fiberglass 7 PVC 10 Asbestos-cement						
2 Brass 4 Galvanized steel 6 Concrete tile 8 RMP (SR) 11 Other (specify)						
SCREEN OR PERFORATION OPENINGS ARE:						
1 Continuous slot 3 Mill slot 5 Gauzed wrapped 8 Saw cut 11 None (open hole)						
2 Louvered shutter 4 Key punched 6 Wire wrapped 9 Drilled holes 10 Other (specify)						
SCREEN-PERFORATED INTERVALS: From 20 ft. to 30 ft. From ft. to ft. From ft. to ft. From ft. to ft.						
GRAVEL PACK INTERVALS: From 18 ft. to 30 ft. From ft. to ft. From ft. to ft. From ft. to ft.						
6 GROUT MATERIAL: 1 Neat cement 2 Cement grout 3 Bentonite 4 Other						
Grout Intervals From 1 ft. to 18 ft. From ft. to ft. From ft. to ft. From ft. to ft.						
What is the nearest source of possible contamination:						
1 Septic tank 4 Lateral lines 7 Pit privy 10 Livestock pens 14 Abandoned water well						
2 Sewer lines 5 Cess pool 8 Sewage lagoon 11 Fuel storage 15 Oil well/ Gas well						
3 Watertight sewer lines 6 Seepage pit 9 Feedyard 12 Fertilizer storage 16 Other (specify below)						
13 Insecticide storage						
Direction from well? How many feet?						
FROM	TO	CODE	LITHOLOGIC LOG	FROM	TO	PLUGGING INTERVALS
0	0.3		Topsoil			
0.3	2		Fill, Silty Clay, brown, with sandstone chunks			
2	21		Silty Clay, dark brown to light brown, few caliche nodules			
21	26		Silt, light brown			
26	27		Sandy Silt, light brown			
27	30		Sand, light brown, medium grained			
7 CONTRACTOR'S OR LANDOWNER'S CERTIFICATION: This water well was (1) constructed, (2) reconstructed, or (3) plugged under my jurisdiction and was completed on (mo/day/yr) 12/16/08 and this record is true to the best of my knowledge and belief. Kansas Water Well Contractor's License No. 531 This Water Well Record was completed on (mo/day/yr) 12/29/08 under the business name of Geotechnical Services Inc. by (signature)						
INSTRUCTIONS: Please fill in blanks and circle the correct answers. Send three copies to Kansas Department of Health and Environment, Bureau of Water, 1000 S W Jackson St., Ste. 420, Topeka, Kansas 66612-1367. Telephone: 913-296-5545. Send one to WATER WELL OWNER and retain one for your records.						