

WATER WELL RECORD Form WWC-5

Division of Water Resources App. No.


20180307

Well ID

Original Record Correction Change in Well Use

1 LOCATION OF WATER WELL: County: Barton Fraction 1/4 SW 1/4 NE 1/4 SE 1/4 Section Number 2 Township Number T 19 S Range Number R 14 E W

2 WELL OWNER: Last Name: F G Holl First: Street or Rural Address where well is located: 2 3/4 East of Heizer

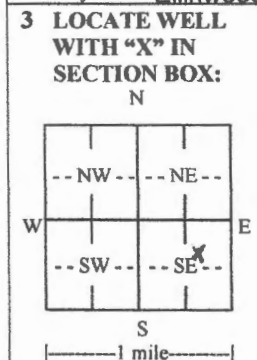

4 DEPTH OF COMPLETED WELL: 89 ft. Depth(s) Groundwater Encountered: 1) 42 ft. 2) 1-10-19 ft. WEL'S STATIC WATER LEVEL: 42 ft.

5 Latitude: 38.42422 (decimal degrees) Longitude: 98.83443 (decimal degrees) Horizontal Datum: NAD 83

7 WELL WATER TO BE USED AS: 1. Domestic: Household, Lawn & Garden, Livestock, Irrigation, Feedlot, Industrial. 2. Public Water Supply: well ID. 3. Dewatering: how many wells? 4. Aquifer Recharge: well ID. 5. Monitoring: well ID. 6. Environmental Remediation: well ID. 7. Air Sparge, Soil Vapor Extraction, Recovery, Injection. 8. Oil Field Water Supply: lease GBF. 9. Test Hole: well ID. 10. Geothermal: how many bores? 11. Closed Loop, Horizontal, Vertical. 12. Open Loop, Surface Discharge, Inj. of Water. 13. Other (specify):

Was a chemical/bacteriological sample submitted to KDHE? No If yes, date sample was submitted: Water well disinfected? Yes

8 TYPE OF CASING USED: Steel PVC Other CASING JOINTS: Glued Clamped Welded Threaded Casing diameter 5 in. to 89 ft. Diameter 18 in. to 26 lbs/ft. Weight SDR-26 Wall thickness or gauge No.

9 GROUT MATERIAL: Neat cement Cement grout Bentonite Other Grout Intervals: From 20 ft. to 0 ft. From 0 ft. to 0 ft.

Nearest source of possible contamination: Septic Tank Lateral Lines Pit Privy Livestock Pens Insecticide Storage Sewer Lines Cess Pool Sewage Lagoon Fuel Storage Abandoned Water Well Watertight Sewer Lines Seepage Pit Feedyard Fertilizer Storage Oil Well/Gas Well Other (Specify) None

Table with columns: 10 FROM, TO, LITHOLOGIC LOG, FROM, TO, LITHO. LOG (cont.) or PLUGGING INTERVALS. Rows include Top soil, Dark brown clay, Light brown clay, Sand & gravel, Dark gray clay, Sand & gravel w/ clay streaks, Clay w/ gravel streaks, Gray shale.

11 CONTRACTOR'S OR LANDOWNER'S CERTIFICATION: This water well was constructed, reconstructed, or plugged under my jurisdiction and was completed on (mo-day-year) 1-10-19 and this record is true to the best of my knowledge and belief. Kansas Water Well Contractor's License No. 134 This Water Well Record was completed on (mo-day-year) 1-28-19 under the business name of Rosencrantz-Bemis Ent Inc Signature Kara Alsp

Mail 1 white copy along with a fee of \$5.00 for each constructed well to: Kansas Department of Health and Environment, Bureau of Water, GWTS Section, 1000 SW Jackson St., Suite 420, Topeka, Kansas 66612-1367. Mail one to Water Well Owner and retain one for your records. Telephone 785-296-5524. Visit us at http://www.kdheks.gov/waterwell/index.html KSA 82a-1212 Revised 7/10/2015