

**WATER WELL RECORD Form WWC-5**


Original Record  Correction  Change in Well Use

Division of Water Resources App. No.  

Well ID   Domestic

**1 LOCATION OF WATER WELL:** County: Barton Fraction SW ¼ SE ¼ SW ¼ SW ¼ Section Number 4 Township Number T 19 S Range Number R 14  E  W

**2 WELL OWNER:** Last Name: Phillips First: Herb Street or Rural Address where well is located (if unknown, distance and direction from nearest town or intersection): If at owner's address, check here:   
Business: Address: 578 NW 40 Rd. Address: City: Great Bend State: KS ZIP: 67530

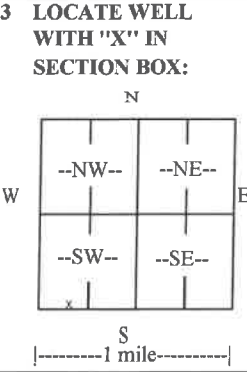

**4 DEPTH OF COMPLETED WELL:** 54 ft.  
Depth(s) Groundwater Encountered: 1) \_\_\_\_\_ ft.  
2) \_\_\_\_\_ ft. 3) \_\_\_\_\_ ft., or 4)  Dry Well  
WELL'S STATIC WATER LEVEL: 10.20 ft.  
 below land surface, measured on (mo-day-yr) 12-13-19  
 above land surface, measured on (mo-day-yr) \_\_\_\_\_  
Pump test data: Well water was not checked ft.  
after \_\_\_\_\_ hours pumping \_\_\_\_\_ gpm  
Well water was \_\_\_\_\_ ft.  
after \_\_\_\_\_ hours pumping \_\_\_\_\_ gpm  
Estimated Yield: \_\_\_\_\_ gpm  
Bore Hole Diameter: 9 in. to 55 ft. and \_\_\_\_\_ in. to \_\_\_\_\_ ft.

**5 Latitude:** 38.42022 (decimal degrees)  
**Longitude:** -98.882022 (decimal degrees)  
Horizontal Datum:  WGS 84  NAD 83  NAD 27  
Source for Latitude/Longitude :  
 GPS (unit make/model: \_\_\_\_\_)  
(WAAS enabled?  Yes  No)  
 Land Survey  Topographic Map  
 Online Mapper: \_\_\_\_\_  
**6 Elevation:** Unknown \_\_\_\_\_ ft.  Ground Level  TOC  
Source:  Land Survey  GPS  Topographic Map  
 Other \_\_\_\_\_

**7 WELL WATER TO BE USED AS:**

1. Domestic: <input checked="" type="checkbox"/> Household <input type="checkbox"/> Lawn & Garden <input type="checkbox"/> Livestock	2. <input type="checkbox"/> Irrigation	3. <input type="checkbox"/> Feedlot	4. <input type="checkbox"/> Industrial	5. <input type="checkbox"/> Public Water Supply: well ID _____	6. <input type="checkbox"/> Dewatering: how many wells? _____	7. <input type="checkbox"/> Aquifer Recharge: well ID _____	8. <input type="checkbox"/> Monitoring: well ID _____	9. Environmental Remediation: well ID _____ <input type="checkbox"/> Air Sparge <input type="checkbox"/> Soil Vapor Extraction <input type="checkbox"/> Recovery <input type="checkbox"/> Injection	10. <input type="checkbox"/> Oil Field Water Supply: lease _____	11. Test Hole: well ID _____ <input type="checkbox"/> Cased <input type="checkbox"/> Uncased <input type="checkbox"/> Geotechnical	12. Geothermal: how many bores? a) Closed Loop <input type="checkbox"/> Horizontal <input type="checkbox"/> Vertical b) Open Loop <input type="checkbox"/> Surface Discharge <input type="checkbox"/> Inj. of Water	13. <input type="checkbox"/> Other (specify): _____
--	--	-------------------------------------	--	--	---	---	---	--	--	---	---	---

**Was a chemical/bacteriological sample submitted to KDHE?**  Yes  No If yes, date sample was submitted: \_\_\_\_\_  
Water well disinfected?  Yes  No

**8 TYPE OF CASING USED:**  Steel  PVC CASING JOINTS:  Glued  Clamped  Welded  Threaded  Other  
Casing diameter 5 in. to 42 ft., Diameter \_\_\_\_\_ in. to \_\_\_\_\_ ft., Diameter \_\_\_\_\_ in. to \_\_\_\_\_ ft.  
Casing height above land surface 24 in. Weight 2.36 lbs./ft. Wall thickness or gauge No. 214  
**TYPE OF SCREEN OR PERFORATION MATERIAL:**  
 Steel  Stainless Steel  Fiberglass  PVC  Other (Specify) \_\_\_\_\_  
 Brass  Galvanized Steel  Concrete tile  None used (open hole)  
**SCREEN OR PERFORATION OPENINGS ARE:**  
 Continuous Slot  Mill Slot  Gauze Wrapped  Torch Cut  Drilled Holes  Other (Specify) \_\_\_\_\_  
 Louvered Shutter  Key Punched  Wire Wrapped  Saw Cut  None (Open Hole)  
**SCREEN-PERFORATED INTERVALS:** From 42 ft. to 52 ft., From \_\_\_\_\_ ft. to \_\_\_\_\_ ft., From \_\_\_\_\_ ft. to \_\_\_\_\_ ft.  
**GRAVEL PACK INTERVALS:** From 22 ft. to 55 ft., From \_\_\_\_\_ ft. to \_\_\_\_\_ ft., From \_\_\_\_\_ ft. to \_\_\_\_\_ ft.

**9 GROUT MATERIAL:**  Neat cement  Cement grout  Bentonite  Other \_\_\_\_\_  
Grout Intervals: From 0 ft. to 22 ft., From \_\_\_\_\_ ft. to \_\_\_\_\_ ft., From \_\_\_\_\_ ft. to \_\_\_\_\_ ft.

**Nearest source of possible contamination:**  
 Septic Tank  Lateral Lines  Pit Privy  Livestock Pens  Insecticide Storage  
 Sewer Lines  Cess Pool  Sewage Lagoon  Fuel Storage  Abandoned Water Well  
 Watertight Sewer Lines  Seepage Pit  Feedyard  Fertilizer Storage  Oil Well/Gas Well  
 Other (Specify) None Known \_\_\_\_\_  
Direction from well? \_\_\_\_\_ Distance from well? \_\_\_\_\_ ft.

10 FROM	TO	LITHOLOGIC LOG	FROM	TO	LITHO. LOG (cont.) or PLUGGING INTERVALS
0	6	Topsoil			RECEIVED
6	33	Clay, gray			
33	52	Sand, coarse to fine, with fine gravel, medium			DEC 24 2019
52	55	Clay, red & gray			BUREAU OF WATER

**Notes:**

**11 CONTRACTOR'S OR LANDOWNER'S CERTIFICATION:** This water well was  constructed,  reconstructed, or  plugged under my jurisdiction and was completed on (mo-day-year) 12-13-19 and this record is true to the best of my knowledge and belief.  
Kansas Water Well Contractor's License No. 185 This Water Well Record was completed on (mo-day-year) 12-16-19  
under the business name of Clarke Well & Equipment, Inc. Signature \_\_\_\_\_