

WATER WELL RECORD Form WWC-5

Original Record Correction Change in Well Use


Division of Water Resources App. No.

35,591

Well ID

1 LOCATION OF WATER WELL: County: **Barton** Fraction $\frac{1}{4}$ SE $\frac{1}{4}$ SE $\frac{1}{4}$ NE $\frac{1}{4}$ Section Number **5** Township Number **T 19 S** Range Number **R 14** E W

2 WELL OWNER: Last Name: **Harms Family Revocable Trust** First: **ABBB PO Drawer J** Street or Rural Address where well is located (if unknown, distance and direction from nearest town or intersection): **1/4 North of Heizer**
 Address: **ABBB PO Drawer J**
 City: **Great Bend** State: **KS** ZIP: **67530**

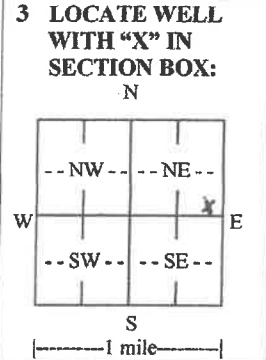

4 DEPTH OF COMPLETED WELL: **75** ft.
 Depth(s) Groundwater Encountered: 1) ft.
 2) ft. 3) ft., or 4) Dry Well
 WELL'S STATIC WATER LEVEL: **12** ft.
 below land surface, measured on (mo-day-yr) **2-6-19**
 above land surface, measured on (mo-day-yr)
 Pump test data: Well water was **26** ft.
 after **2** hours pumping **689** gpm
 Well water was **35** ft.
 after **2 1/2** hours pumping **1063** gpm
 Estimated Yield: gpm
 Bore Hole Diameter: **30** in. to **75** ft. and
 in. to ft.

5 Latitude: (decimal degrees)
Longitude: (decimal degrees)
Horizontal Datum: WGS 84 NAD 83 NAD 27
Source for Latitude/Longitude:
 GPS (unit make/model:)
 (WAAS enabled? Yes No)
 Land Survey Topographic Map
 Online Mapper:
6 Elevation: ft. Ground Level TOC
Source: Land Survey GPS Topographic Map
 Other

7 WELL WATER TO BE USED AS:

1. Domestic: <input type="checkbox"/> Household <input type="checkbox"/> Lawn & Garden <input type="checkbox"/> Livestock	5. <input type="checkbox"/> Public Water Supply: well ID	10. <input type="checkbox"/> Oil Field Water Supply: lease
2. <input checked="" type="checkbox"/> Irrigation	6. <input type="checkbox"/> Dewatering: how many wells?	11. Test Hole: well ID
3. <input type="checkbox"/> Feedlot	7. <input type="checkbox"/> Aquifer Recharge: well ID	<input type="checkbox"/> Cased <input type="checkbox"/> Uncased <input type="checkbox"/> Geotechnical
4. <input type="checkbox"/> Industrial	8. <input type="checkbox"/> Monitoring: well ID	12. Geothermal: how many bores?
	9. Environmental Remediation: well ID	a) Closed Loop <input type="checkbox"/> Horizontal <input type="checkbox"/> Vertical
	<input type="checkbox"/> Air Sparge <input type="checkbox"/> Soil Vapor Extraction	b) Open Loop <input type="checkbox"/> Surface Discharge <input type="checkbox"/> Inj. of Water
	<input type="checkbox"/> Recovery <input type="checkbox"/> Injection	13. <input type="checkbox"/> Other (specify):

Was a chemical/bacteriological sample submitted to KDHE? Yes No If yes, date sample was submitted:
 Water well disinfected? Yes No

8 TYPE OF CASING USED: Steel PVC Other CASING JOINTS: Glued Clamped Welded Threaded
 Casing diameter **16** in. to **75** ft., Diameter in. to ft., Diameter in. to ft.
 Casing height above land surface **18** in. Weight **Sch 40** lbs./ft. Wall thickness or gauge No.
TYPE OF SCREEN OR PERFORATION MATERIAL:
 Steel Stainless Steel Fiberglass PVC Other (Specify)
 Brass Galvanized Steel Concrete tile None used (open hole)
SCREEN OR PERFORATION OPENINGS ARE:
 Continuous Slot Mill Slot Gauze Wrapped Torch Cut Drilled Holes Other (Specify)
 Louvered Shutter Key Punched Wire Wrapped Saw Cut None (Open Hole)
SCREEN-PERFORATED INTERVALS: From **75** ft. to **35** ft., From ft. to ft.
GRAVEL PACK INTERVALS: From **75** ft. to **20** ft., From ft. to ft.

9 GROUT MATERIAL: Neat cement Cement grout Bentonite Other
 Grout Intervals: From ft. to ft., From **20** ft. to **0** ft., From ft. to ft.
Nearest source of possible contamination:
 Septic Tank Lateral Lines Pit Privy Livestock Pens Insecticide Storage
 Sewer Lines Cess Pool Sewage Lagoon Fuel Storage Abandoned Water Well
 Watertight Sewer Lines Seepage Pit Feedyard Fertilizer Storage Oil Well/Gas Well
 Other (Specify) ... **None**
 Direction from well? Distance from well? ft.

10 FROM	TO	LITHOLOGIC LOG	FROM	TO	LITHO. LOG (cont.) or PLUGGING INTERVALS
0	2	Top soil	75		Yellow/ red/ gray shale
2	32	Tan clay			
32	51	Sand & gravel- small to med			
51	54	Blue/ green clay			
54	62	Sand & gravel- small to med			
62	65	Gray clay			
65	71	Sand & gravel			
71	72	Gray clay			
72	75	Sand & gravel- small to med			

Notes:

11 CONTRACTOR'S OR LANDOWNER'S CERTIFICATION: This water well was constructed, reconstructed, or plugged under my jurisdiction and was completed on (mo-day-year) ... **4-1-19** and this record is true to the best of my knowledge and belief. Kansas Water Well Contractor's License No. ... **134** This Water Well Record was completed on (mo-day-year) ... **4-22-19** under the business name of ... **Rosencrantz- Bemis Ent Inc** Signature *[Signature]*