

1 LOCATION OF WATER WELL:	Fraction	Section Number	Township Number	Range Number
County: <u>BARTON</u>	<u>NE</u> $\frac{1}{4}$ <u>NE</u> $\frac{1}{4}$ SE $\frac{1}{4}$	<u>25</u>	T <u>19</u> S	R <u>14</u> W EW

Distance and direction from nearest town or city street address of well if located within city?

5965 BROADWAY

2 WATER WELL OWNER: BARTON COUNTY DEVELOPMENT


RR#, St. Address, Box # : 1401 CHERRY LANE

Board of Agriculture, Division of Water Resources

City, State, ZIP Code : GREAT BEND, KS. 67530

Application Number:

3 LOCATE WELL'S LOCATION WITH AN "X" IN SECTION BOX: 4 DEPTH OF COMPLETED WELL: 63 ft. ELEVATION:

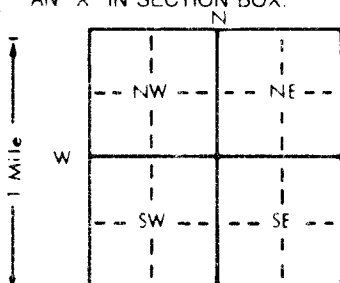

Depth(s) Groundwater Encountered 1. ft. 2. ft. 3. ft.

WELL'S STATIC WATER LEVEL 1.5 ft. below land surface measured on mo/day/yr

Pump test data: Well water was ft. after hours pumping gpm

Est. Yield gpm: Well water was ft. after hours pumping gpm

Bore Hole Diameter 9 in. to ft. and in. to ft.

WELL WATER TO BE USED AS: 5 Public water supply 8 Air conditioning 11 Injection well

X1 Domestic 3 Feedlot 6 Oil field water supply 9 Dewatering 12 Other (Specify below)

2 Irrigation 4 Industrial 7 Lawn and garden only 10 Monitoring well

Was a chemical bacteriological sample submitted to Department? Yes No X If yes, mo/day/yr sample was submitted

Water Well Disinfected? Yes X No

5 TYPE OF BLANK CASING USED:

1 Steel 3 RMP (SR)

5 Wrought iron

8 Concrete tile

CASING JOINTS: Glued X Clamped

X PVC 4 ABS

6 Asbestos-Cement

9 Other (specify below)

Welded

7 Fiberglass

Threaded

Blank casing diameter 5 in. to 53 ft. Dia in. to ft. Dia in. to ft.

Casing height above land surface 24 in. weight lbs. ft. Wall thickness or gauge No.

TYPE OF SCREEN OR PERFORATION MATERIAL

1 Steel 3 Stainless steel

5 Fiberglass

X7 PVC

10 Asbestos-cement

2 Brass 4 Galvanized steel

6 Concrete tile

8 RMP (SR)

11 Other (specify)

9 ABS

12 None used (open hole)

SCREEN OR PERFORATION OPENINGS ARE:

1 Continuous slot X 3 Mill slot

5 Gauzed wrapped

8 Saw cut

11 None (open hole)

2 Louvered shutter 4 Key punched

6 Wire wrapped

9 Drilled holes

7 Torch cut

10 Other (specify)

SCREEN-PERFORATED INTERVALS: From 53 ft. to 63 ft. From ft. to ft.

From ft. to ft. From ft. to ft.

GRAVEL PACK INTERVALS: From 23 ft. to 63 ft. From ft. to ft.

From ft. to ft. From ft. to ft.

6 GROUT MATERIAL: 1 Neat cement 2 Cement grout X Bentonite 4 Other

Grout Intervals: From 3 ft. to 23 ft. From ft. to ft.

What is the nearest source of possible contamination.

1 Septic tank 4 Lateral lines

7 Pit privy

10 Livestock pens

14 Abandoned water well

2 Sewer lines 5 Cess pool

8 Sewage lagoon

11 Fuel storage

15 Oil well Gas well

3 Watertight sewer lines 6 Seepage pit

9 Feedyard

12 Fertilizer storage

16 Other (specify below)

13 Insecticide storage

NONE KNOWN

Direction from well?

How many feet?

FROM	TO	LITHOLOGIC LOG	FROM	TO	PLUGGING INTERVALS
0	3	TOP SOIL			
3	11	CLAY			
11	38	GRAVEL			
38	50	CLAY			
50	63	GRAVEL			

7 CONTRACTOR'S OR LANDOWNER'S CERTIFICATION: This water well was (X) constructed, (2) reconstructed, or (3) plugged under my jurisdiction and was completed on (mo/day/yr) 9-28-94 and this record is true to the best of my knowledge and belief. Kansas

Water Well Contractor's License No. 462 This Water Well Record was completed on (mo/day/yr) 10-29-94

under the business name of SAM'S WATER WELL SERVICE by (signature) Sam Rappaport

INSTRUCTIONS: Use typewriter or ball point pen. PLEASE PRESS FIRMLY and PRINT clearly. Please fill in blanks, underline or circle the correct answers. Send two copies to Bureau of Health and Environment, Bureau of Water, Topeka, Kansas 66604-0001. Telephone: 913-236-5545. Send one to WATER WELL OWNER and retain one for your records.

OFFICE USE ONLY

T

R

EW

SEC