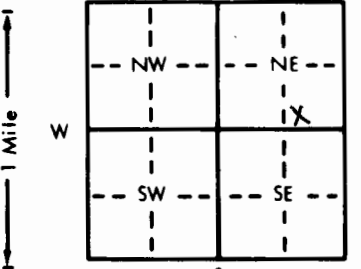


1 LOCATION OF WATER WELL:		Fraction		Section Number		Township Number		Range Number	
County: Barton		SW 1/4 SE 1/4 NE 1/4		10		T 19 S		R 15 E/W	
Distance and direction from nearest town or city street address of well if located within city?									
2 1/2 south 2 1/4 east of Albert									
2 WATER WELL OWNER: Elsie Pascoe									
RR#, St. Address, Box # : Albert, Ks. 67511									
City, State, ZIP Code : Board of Agriculture, Division of Water Resources									
Application Number:									
3 LOCATE WELL'S LOCATION WITH AN "X" IN SECTION BOX:		4 DEPTH OF COMPLETED WELL: 155 ft. ELEVATION:							
		Depth(s) Groundwater Encountered 1. 37 ft. 2. ft. 3. ft.							
		WELL'S STATIC WATER LEVEL 43 ft. below land surface measured on mo/day/yr 8-19-82							
		Pump test data: Well water was ft. after hours pumping gpm							
		Est. Yield NA gpm Well water was ft. after hours pumping gpm							
		Bore Hole Diameter 11 in. to 155 ft. and in. to ft.							
		WELL WATER TO BE USED AS: 5 Public water supply 8 Air conditioning 11 Injection well							
		1 Domestic 3 Feedlot 6 Oil field water supply 9 Dewatering 12 Other (Specify below)							
		2 Irrigation 4 Industrial 7 Lawn and garden only 10 Observation well							
Was a chemical/bacteriological sample submitted to Department? Yes No X If yes, mo/day/yr sample was submitted									
Water Well Disinfected? Yes HTH No									
5 TYPE OF BLANK CASING USED:									
1 Steel 3 RMP (SR) 5 Wrought iron 8 Concrete tile CASING JOINTS: Glued X Clamped									
2 PVC 4 ABS 6 Asbestos-Cement 9 Other (specify below) Welded									
7 Fiberglass Threaded									
Blank casing diameter 5 in. to 50 ft. Dia 5 in. to 110 ft. Dia 5 in. to 130 & 150									
Casing height above land surface 18 in. weight lbs./ft. Wall thickness or gauge No. 258									
TYPE OF SCREEN OR PERFORATION MATERIAL:									
1 Steel 3 Stainless steel 5 Fiberglass 8 RMP (SR) 10 Asbestos-cement									
2 Brass 4 Galvanized steel 6 Concrete tile 9 ABS 11 Other (specify)									
12 None used (open hole)									
SCREEN OR PERFORATION OPENINGS ARE:									
1 Continuous slot 5 Gauzed wrapped 8 Saw cut 11 None (open hole)									
2 Louvered shutter 3 Mill slot 6 Wire wrapped 9 Drilled holes									
4 Key punched 7 Torch cut 10 Other (specify)									
SCREEN-PERFORATED INTERVALS: From 50 ft. to 70 ft. From 110 ft. to 120 ft.									
From 130 ft. to 140 ft. From ft. to ft.									
GRAVEL PACK INTERVALS: From ft. to ft. From ft. to ft.									
From ft. to ft. From ft. to ft.									
6 GROUT MATERIAL: 1 Neat cement 2 Cement grout 3 Bentonite 4 Other									
Grout Intervals: From 0 ft. to 10 ft. From ft. to ft. From ft. to ft.									
What is the nearest source of possible contamination:									
1 Septic tank 4 Lateral lines 7 Pit privy 10 Livestock pens 14 Abandoned water well									
2 Sewer lines 5 Cess pool 8 Sewage lagoon 11 Fuel storage 15 Oil well/Gas well									
3 Watertight sewer lines 6 Seepage pit 9 Feedyard 12 Fertilizer storage 16 Other (specify below)									
13 Insecticide storage									
Direction from well? West How many feet? 80									
FROM TO LITHOLOGIC LOG FROM TO LITHOLOGIC LOG									
0 2 Top soil									
2 10 Dark brown silty clay									
10 35 Light brown silty clay									
35 53 Brown clay & yellow & white clay									
53 65 Hard red sand stone & white sand stone									
65 70 Yellow and red shale									
70 85 Gray and red shale									
85 112 Gray and red shale									
112 116 Sand stone									
116 130 Gray shale and white shale-gritty									
130 140 Dark gray shale-brittle									
140 155 Red and gray shale									
7 CONTRACTOR'S OR LANDOWNER'S CERTIFICATION: This water well was (1) constructed, (2) reconstructed, or (3) plugged under my jurisdiction and was completed on (mo/day/year) 9-28-82 and this record is true to the best of my knowledge and belief. Kansas									
Water Well Contractor's License No. 134 This Water Well Record was completed on (mo/day/yr) 10-8-82									
under the business name of Rosencrantz-Bemis Ent. by (signature) Lora Dodson									
INSTRUCTIONS: Use typewriter or ball point pen, PLEASE PRESS FIRMLY and PRINT clearly. Please fill in blanks, underline or circle the correct answers. Send top three copies to Kansas Department of Health and Environment, Division of Environment, Environmental Geology Section, Topeka, KS 66620. Send one to WATER WELL OWNER and retain one for your records.									