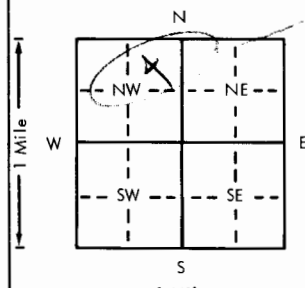


USE TYPEWRITER OR BALL
POINT PEN-PRESS FIRMLY,
PRINT CLEARLY.

WATER WELL RECORD
KSA 82a-1201-1215

Kansas Department of Health and
Environment-Division of Environment
(Water well Contractors)
Topeka, Kansas 66620

Campbell #1

1. Location of well: <u>Barton</u>		County: <u>W</u>	Fraction: <u>1/4 NW 1/4 NE 1/4</u>	Section number: <u>11</u>	Township number: <u>T 19 S</u>	Range number: <u>R 15 E/W</u>
2. Distance and direction from nearest town or city: <u>3 1/2 west 1/4 south Hager Ks</u> Street address of well location if in city:				3. Owner of well: <u>Huskey Delg</u> R.R. or street: <u>800 Bittling Bittling</u> City, state, zip code: <u>Wichita, Ks 67202</u>		
4. Locate with "X" in section below:		Sketch map:		6. Bore hole dia. <u>9</u> in. Completion date <u>2-5-79</u> Well depth <u>80</u> ft.		
				7. ☒ Cable tool ☒ Rotary ☐ Driven ☐ Dug ☐ Hollow rod ☐ Jetted ☐ Bored ☐ Reverse rotary		
5. Type and color of material				8. Use: ☐ Domestic ☐ Public supply ☐ Industry ☐ Irrigation ☐ Air conditioning ☐ Stock ☐ Lawn ☒ Oil field water ☐ Other		
				9. Casing: Material ☐ Height: Above or below Threaded ☐ Welded ☒ Surface <u>12</u> in. RMP ☐ PVC ☒ Weight <u>208.3</u> lbs./ft. Dia <u>5</u> in. to <u>86</u> ft. depth Wall Thickness: inches or Dia. <u>5</u> in. to <u>86</u> ft. depth gage No. <u>200</u>		
				10. Screen: Manufacturer's name <u>Peerless</u> Type <u>SAW</u> Dia. <u>5</u> Slot/gauze <u>1/8</u> Length <u>20</u> Set between <u>80</u> ft. and <u>60</u> ft. ft. and <u>60</u> ft. Gravel pack? <u>yes</u> Size range of material <u>4-18</u>		
				11. Static water level: <u>65</u> ft. below land surface Date <u>2-5-79</u> <u>mg./day/yr.</u>		
				12. Pumping level below land surfaces: ft. after <u> </u> hrs. pumping <u> </u> g.p.m. ft. after <u> </u> hrs. pumping <u> </u> g.p.m. Estimated maximum yield <u> </u> g.p.m.		
				13. Water sample submitted: <u> </u> mo./day/yr. ☐ Yes ☒ No Date <u> </u>		
				14. Well head completion: <u> </u> Pitless adapter <u>12</u> Inches above grade		
				15. Well grouted <u>yes</u> With: ☒ Neat cement ☒ Bentonite ☐ Concrete Depth: From <u>0</u> ft. to <u>10</u> ft.		
				16. Nearest source of possible contamination: ft. <u> </u> Direction <u> </u> Type <u>None</u> Well disinfected upon completion? ☐ Yes ☒ No		
				17. Pump: ☒ Not installed Manufacturer's name <u> </u> Model number <u> </u> HP <u> </u> Volts <u> </u> Length of drop pipe <u> </u> ft. capacity <u> </u> g.p.m. Type: ☐ Submersible ☐ Turbine ☐ Jet ☐ Reciprocating ☐ Centrifugal ☐ Other		
(Use a second sheet if needed)						
18. Elevation:		19. Remarks:		20. Water well contractor's certification: This well was drilled under my jurisdiction and this report is true to the best of my knowledge and belief. <u>Meeks Water Well</u> <u>143</u> Business name License No. Address <u>Great Bend Ks 67530</u> Signed <u>Floyd Campbell</u> Date <u>2-5-79</u> Authorized representative		
Topography: ☐ Hill ☒ Slope ☐ Upland ☐ Valley						

19 150 W 11
T
R
Sec
1/4 1/4 1/4
NUNANE