


1 LOCATION OF WATER WELL:	Fraction	Section Number	Township Number	Range Number
County: <u>Barton</u>	<u>SW 1/4 SE 1/4 SW 1/4</u>	<u>14</u>	T <u>19</u> S	R <u>15</u> EW

Distance and direction from nearest town or city street address of well if located within city?

8 West 2 North Ct Bend, KS

2 WATER WELL OWNER:	Land owner	Board of Agriculture, Division of Water Resources
RR#, St. Address, Box # :	<u>Red Tiger Drlg</u>	
City, State, ZIP Code :	<u>Wichita, KS</u>	Application Number: <u>83-217</u>

3 LOCATE WELL'S LOCATION WITH AN "X" IN SECTION BOX:	4 DEPTH OF COMPLETED WELL: <u>185</u> ft. ELEVATION:
--	--

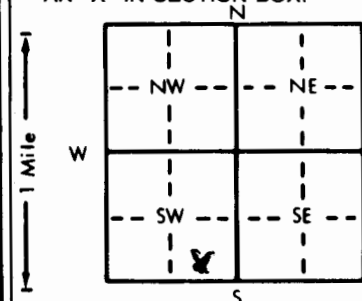

Depth(s) Groundwater Encountered	ft. 2.	ft. 3.
WELL'S STATIC WATER LEVEL	<u>30</u> ft. below land surface measured on mo/day/yr	<u>6-18-83</u>
Pump test data: Well water was	ft. after	hours pumping
Est. Yield	gpm: Well water was	ft. after
Bore Hole Diameter	in. to	ft. and
WELL WATER TO BE USED AS:	5 Public water supply	8 Air conditioning
1 Domestic	3 Feedlot	6 Oil field water supply
2 Irrigation	4 Industrial	7 Lawn and garden only
		10 Observation well
Was a chemical/bacteriological sample submitted to Department? Yes	No	If yes, mo/day/yr sample was submitted
Water Well Disinfected? Yes	No	

5 TYPE OF BLANK CASING USED:	5 Wrought iron	8 Concrete tile	CASING JOINTS: Glued
1 Steel	3 RMP (SR)	6 Asbestos-Cement	9 Other (specify below)
2 PVC	4 ABS	7 Fiberglass	

Blank casing diameter	in. to	ft., Dia	in. to	ft., Dia	in. to	ft.
Casing height above land surface	<u>3 ft below</u>	in. weight	lbs./ft. Wall thickness or gauge No.			

TYPE OF SCREEN OR PERFORATION MATERIAL:	7 PVC	10 Asbestos-cement
1 Steel	3 Stainless steel	5 Fiberglass
2 Brass	4 Galvanized steel	6 Concrete tile
		9 ABS
		11 Other (specify)
		12 None used (open hole)

SCREEN OR PERFORATION OPENINGS ARE:	5 Gauzed wrapped	8 Saw cut	11 None (open hole)
1 Continuous slot	3 Mill slot	6 Wire wrapped	9 Drilled holes
2 Louvered shutter	4 Key punched	7 Torch cut	10 Other (specify)

SCREEN-PERFORATED INTERVALS:	From	ft. to	ft. From	ft. to	ft. From	ft. to
GRAVEL PACK INTERVALS:	From	ft. to	ft. From	ft. to	ft. From	ft. to

6 GROUT MATERIAL:	1 Neat cement	2 Cement grout	3 Bentonite	4 Other
GROUT INTERVALS:	From	ft. to	ft. From	ft. to

What is the nearest source of possible contamination:	10 Livestock pens	14 Abandoned water well
1 Septic tank	4 Lateral lines	7 Pit privy
2 Sewer lines	5 Cess pool	8 Sewage lagoon
3 Watertight sewer lines	6 Seepage pit	9 Feedyard
		11 Fuel storage
		12 Fertilizer storage
		13 Insecticide storage
		15 Oil well/Gas well
		16 Other (specify below)

Direction from well?	How many feet?
----------------------	----------------

FROM	TO	LITHOLOGIC LOG	FROM	TO	LITHOLOGIC LOG
<u>185</u>	<u>30</u>	<u>Sand & Gravel</u>	<u>21.08</u>	<u>cu</u>	<u>ft</u>
<u>30</u>	<u>6</u>	<u>Clay</u>	<u>3.26</u>	<u>cu</u>	<u>ft</u>
<u>6</u>	<u>3</u>	<u>Cement</u>	<u>0.91</u>	<u>cu</u>	<u>ft</u>

7 CONTRACTOR'S OR LANDOWNER'S CERTIFICATION:	This water well was (1) constructed, (2) reconstructed, or (3) plugged under my jurisdiction and was completed on (mo/day/year) <u>6-18-83</u> and this record is true to the best of my knowledge and belief. Kansas Water Well Contractor's License No. <u>Red Tiger Drlg Co</u> This Water Well Record was completed on (mo/day/yr) <u>6-18-83</u> under the business name of <u>Red Tiger Drlg Co</u> by (signature) <u>Clayton Engel</u>
--	---

INSTRUCTIONS: Use typewriter or ball point pen, PLEASE PRESS FIRMLY and PRINT clearly. Please fill in blanks, underline or circle the correct answers. Send top three copies to Kansas Department of Health and Environment, Division of Environment, Environmental Geology Section, Topeka, KS 66620. Send one to WATER WELL OWNER and retain one for your records.