

1 LOCATION OF WATER WELL:	Fraction	Section Number	Township Number	Range, Number
County: Barton	NW 1/4 SW 1/4 SE 1/4	14	T 19 S	R 15 E (W)

Distance and direction from nearest town or city street address of well if located within city?


Gt Bend, Ks 10 mi west 3 mi north

2 WATER WELL OWNER:	Board of Agriculture, Division of Water Resources
RR#, St. Address, Box # :	Application Number:
City, State, ZIP Code :	

Mrs Alta Eberly } Red Tiger Drk
Esccondido, Calif } Wichita, Ks

Application Number: T83-404

3 LOCATE WELL'S LOCATION WITH AN "X" IN SECTION BOX:	4 DEPTH OF COMPLETED WELL	ELEVATION:
--	---------------------------	------------

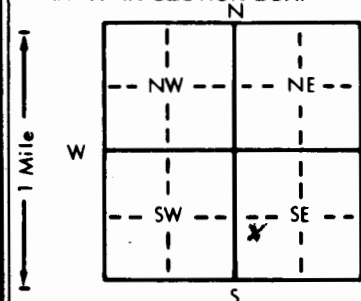

Depth(s) Groundwater Encountered 195 ft. ELEVATION:

WELL'S STATIC WATER LEVEL 42 ft. below land surface measured on mo/day/yr 9-20-83

Pump test data: Well water was ft. after hours pumping gpm

Est. Yield gpm: Well water was ft. after hours pumping gpm

Bore Hole Diameter: in. to ft. and in. to ft.

WELL WATER TO BE USED AS:

1 Domestic 3 Feedlot 6 Oil field water supply 8 Air conditioning 11 Injection well

2 Irrigation 4 Industrial 7 Lawn and garden only 9 Dewatering 12 Other (Specify below)

Was a chemical/bacteriological sample submitted to Department? Yes No If yes, mo/day/yr sample was submitted

Water Well Disinfected? Yes No

5 TYPE OF BLANK CASING USED:	5 Wrought iron	8 Concrete tile	CASING JOINTS: Glued X Clamped
------------------------------	----------------	-----------------	--------------------------------

1 Steel 3 RMP (SR) 6 Asbestos-Cement 9 Other (specify below) Welded

PVC 4 ABS 7 Fiberglass Threaded

Blank casing diameter 5 in. to ft. Dia in. to ft. Dia in. to ft.

Casing height above land surface in. weight lbs./ft. Wall thickness or gauge No.

TYPE OF SCREEN OR PERFORATION MATERIAL:

1 Steel 3 Stainless steel 5 Fiberglass 8 RMP (SR) 11 Other (specify)

2 Brass 4 Galvanized steel 6 Concrete tile 9 ABS 12 None used (open hole)

SCREEN OR PERFORATION OPENINGS ARE:

1 Continuous slot 3 Mill slot 5 Gauzed wrapped 8 Saw cut 11 None (open hole)

2 Louvered shutter 4 Key punched 6 Wire wrapped 9 Drilled holes

7 Torch cut 10 Other (specify)

SCREEN-PERFORATED INTERVALS: From ft. to ft. From ft. to ft.

From ft. to ft. From ft. to ft.

GRAVEL PACK INTERVALS: From ft. to ft. From ft. to ft.

From ft. to ft. From ft. to ft.

6 GROUT MATERIAL:	1 Neat cement	2 Cement grout	3 Bentonite	4 Other
-------------------	---------------	----------------	-------------	---------

Grout Intervals: From 6 ft. to 3 ft. From ft. to ft. From ft. to ft.

What is the nearest source of possible contamination:

1 Septic tank 4 Lateral lines 7 Pit privy 10 Livestock pens 14 Abandoned water well

2 Sewer lines 5 Cess pool 8 Sewage lagoon 11 Fuel storage 15 Oil well/Gas well

3 Watertight sewer lines 6 Seepage pit 9 Feedyard 12 Fertilizer storage 16 Other (specify below)

Direction from well? How many feet? 125 ft. North West

FROM	TO	LITHOLOGIC LOG	FROM	TO	LITHOLOGIC LOG
195	42	Sand & Gravel	20.8	cu ft	
42	6	Clay	4.8	cu ft	
6	3	Neat Cement	.40	cu ft	

7 CONTRACTOR'S OR LANDOWNER'S CERTIFICATION:	This water well was (1) constructed, (2) reconstructed, or (3) plugged under my jurisdiction and was completed on (mo/day/year) 9-20-83 and this record is true to the best of my knowledge and belief. Kansas
--	--

Water Well Contractor's License No. This Water Well Record was completed on (mo/day/yr) 9-28-83

under the business name of Red Tiger Drk by (signature) Clayton Engel

INSTRUCTIONS: Use typewriter or ball point pen, PLEASE PRESS FIRMLY and PRINT clearly. Please fill in blanks, underline or circle the correct answers. Send top

three copies to Kansas Department of Health and Environment, Division of Environment, Environmental Geology Section, Topeka, KS 66620. Send one to WATER WELL

OWNER and retain one for your records.