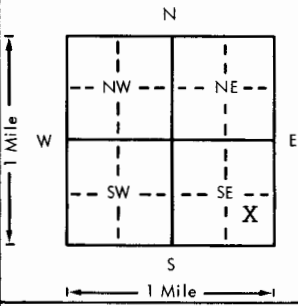


26A
USE TYPEWRITER OR BALL
POINT PEN-PRESS FIRMLY,
PRINT CLEARLY.

WATER WELL RECORD
KSA 82a-1201-1215

Kansas Department of Health and
Environment-Division of Environment
(Water well Contractors)
Topeka, Kansas 66620

1. Location of well:		County Barton	Fraction 1/4 SE 1/4 SE 1/4	Section number 22	Township number T 19 S	Range number R 15 E
2. Distance and direction from nearest town or city: 9 miles West of Great Bend, KS Street address of well location if in city:				3. Owner of well: Ray Schenkel R.R. or street: 3614 Meadow Lark City, state, zip code: Great Bend, KS 67530		
4. Locate with "X" in section below:		Sketch map:		6. Bore hole dia. 9 in. Completion date 5-10-78 Well depth 124 ft. Pump Set 5-12-78		
				7. Cable tool ☒ Rotary ☐ Driven ☐ Dug ☐ Hollow rod ☐ Jetted ☐ Bored ☐ Reverse rotary		
5. Type and color of material				From	To	8. Use: ☒ Domestic ☐ Public supply ☐ Industry ☐ Irrigation ☐ Air conditioning ☐ Stock ☐ Lawn ☐ Oil field water ☐ Other
Top soil				0	2	9. Casing: Material Styrene Height Above or below Threaded ☐ Welded ☒ Surface 12 in. RMP ☐ PVC ☐ Weight 1.5 lbs./ft. Dia. 5 in. to 94 ft. depth Wall Thickness: inches or Dia. ☐ in. to ☐ ft. depth Gauge No. .200
Hard brown clay				2	14	10. Screen: Manufacturer's name Jess & Lowell Type Styrene 200 Dia. 5" ☒ Slot gauze 1/8" Length 30' Set between 94 ft. and 124 ft. Set between ☐ ft. and ☐ ft. Gravel pack? yes Size range of material 3/8-200
Brown & white clay				14	48	11. Static water level: ☐ mo./day/yr. 27 ft. below land surface Date 5-10-78
Blue clay				48	61	12. Pumping level below land surfaces: Not Checked ☐ ft. after ☐ hrs. pumping ☐ g.p.m. ☐ ft. after ☐ hrs. pumping ☐ g.p.m. Estimated maximum yield ☐ g.p.m.
Soft blue & black clay				61	68	13. Water sample submitted: ☐ mo./day/yr. ☐ Yes ☒ No Date ☐
Blue clay				68	93	14. Well head completion: ☐ Pitless adapter 12 Inches above grade
Water clay & soft sandstone				93	115	15. Well grouted? yes With: ☒ Neat cement ☐ Bentonite ☐ Concrete Depth: From 0 ft. to 10 ft.
Dakota drift & clay streaks				115	123	16. Nearest source of possible contamination: FIELD ft. ☐ Direction ☐ Type ☐ Well disinfected upon completion? ☒ Yes ☐ No
Dakota clay				123	124	17. Pump: ☐ Not installed Manufacturer's name Berkeley Pump Co Model number 4BL-15 HP 1 Volts 230 Length of drop pipe 84 ft. capacity 15 g.p.m. Type: ☒ Submersible ☐ Turbine ☐ Jet ☐ Reciprocating ☐ Centrifugal ☐ Other
(Use a second sheet if needed)						
18. Elevation: 1921 Topography: ☐ Hill ☐ Slope ☐ Upland ☐ Valley		19. Remarks:		20. Water well contractor's certification: This well was drilled under my jurisdiction and this report is true to the best of my knowledge and belief. Clarke Well & Eq., Inc. 185 Business name Great Bend, KS 67530 License No. Address 5-16-78 Signed [Signature] Authorized representative Date		