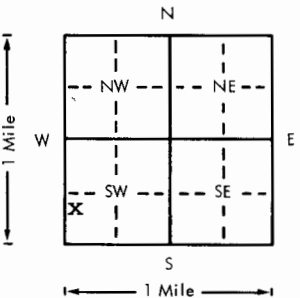


USE TYPEWRITER OR BALL
POINT PEN-PRESS FIRMLY,
PRINT CLEARLY.

WATER WELL RECORD
KSA 82a-1201-1215

Kansas Department of Health and
Environment-Division of Environment
(Water well Contractors)
Topeka, Kansas 66620

1. Location of well:		County Barton	Fraction NW 1/4 SW 1/4 SW 1/4	Section number 29	Township number T 19 S	Range number R 15 E
2. Distance and direction from nearest town or city: 10 1/2 miles West of Great Bend, KS 67530 Street address of well location if in city:				3. Owner of well: Mrs. Edwin Geil R.R. or street: Route 4 City, state, zip code: Great Bend, KS 67530		
4. Locate with "X" in section below:		Sketch map:		6. Bore hole dia. <u>9</u> in. Completion date <u>2-3-78</u> Well depth <u>73</u> ft.		
				7. ☐ Cable tool ☐ Rotary ☐ Driven ☐ Dug ☐ Hollow rod ☐ Jetted ☐ Bored ☒ Reverse rotary		
5. Type and color of material				From	To	8. Use: ☒ Domestic ☐ Public supply ☐ Industry ☐ Irrigation ☐ Air conditioning ☐ Stock ☐ Lawn ☐ Oil field water ☐ Other
Top soil				0	3	9. Casing: Material <u>Styrene</u> Height: <u>Above</u> or below Threaded ☐ Welded ☒ Surface <u>12</u> in. RMP ☐ PVC ☐ Weight <u>1.5</u> lbs./ft. Dia. <u>5</u> in. to <u>33</u> ft. depth Wall Thickness: inches or Dia. <u>5</u> in. to <u>33</u> ft. depth gage No. <u># 200</u>
Yellow clay				3	12	10. Screen: Manufacturer's name <u>Jess & Lowell</u> Type <u>Styrene 200</u> Dia. <u>5"</u> Slot/gauze <u>1/8</u> Length <u>40'</u> Set between <u>33</u> ft. and <u>73</u> ft. ft. and <u>73</u> ft. Gravel pack? <u>yes</u> Size range of material <u>3/8-200</u>
Brown clay				12	19	11. Static water level: <u>27' 6"</u> ft. below land surface Date <u>2-3-78</u> mo./day/yr.
Yellow & brown clay				19	32	12. Pumping level below land surfaces: <u>Not Checked</u> ft. after <u> </u> hrs. pumping <u> </u> g.p.m. ft. after <u> </u> hrs. pumping <u> </u> g.p.m. Estimated maximum yield <u> </u> g.p.m.
Brown water clay - sandy				32	43	13. Water sample submitted: <u> </u> mo./day/yr. <u> </u> Yes ☒ No <u> </u> Date <u> </u>
Brown clay - hard				43	46	14. Well head completion: <u> </u> Pitless adapter <u>12</u> Inches above grade
Brown water clay - sandy				46	59	15. Well grouted? <u>Yes</u> With: ☒ Neat cement <u> </u> Bentonite <u> </u> Concrete Depth: From <u>0</u> ft. to <u>10</u> ft.
XXXXX Hard yellow clay				59	63	16. Nearest source of possible contamination: <u>Field</u> ft. <u> </u> Direction <u> </u> Type <u> </u> Well disinfected upon completion? ☒ Yes <u> </u> No
Brown water clay - sandy				63	71	17. Pump: ☒ Not installed Manufacturer's name <u> </u> Model number <u> </u> HP <u> </u> Volts <u> </u> Length of drop pipe <u> </u> ft. capacity <u> </u> g.p.m. Type: <u> </u> Submersible <u> </u> Turbine <u> </u> Jet <u> </u> Reciprocating <u> </u> Centrifugal <u> </u> Other
Hard brown clay				71	73	
(Use a second sheet if needed)						
18. Elevation:		19. Remarks: 1956		20. Water well contractor's certification: This well was drilled under my jurisdiction and this report is true to the best of my knowledge and belief. Clarke Well & Equip., Inc. 185 Business name <u>Great Bend, KS 67530</u> License No. <u> </u> Address <u> </u> Date <u>2-6-78</u> Signed <u>Edw. Geil</u> Authorized representative		
Topography: <u> </u> Hill <u> </u> Slope <u> </u> Upland <u> </u> Valley						