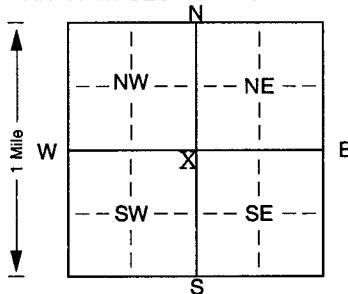


1 LOCATION OF WATER WELL: County: Barton		FRACTION NE 1/4 NE 1/4 SW 1/4		SECTION NUMBER 3		TOWNSHIP NUMBER T 19 S		RANGE NUMBER R 15W EW	
2 WATER WELL OWNER: Paul Vandermeer RR#, St. Address, Box # : 3119 19th City, State, ZIP Code : Great Bend, Ks. 67530									
3 LOCATE WELL'S LOCATION WITH AN "X" IN SECTION BOX: 									
4 DEPTH OF COMPLETED WELL: 90 ft. ELEVATION: unknown Depth(s) Groundwater Encountered 1. 68 ft. 2. ft. 3. ft. WELL'S STATIC WATER LEVEL 68 ft. below land surface measured on mo/day/yr 04/11/03 Pump test data: Well water was ft. after hours pumping gpm Est. Yield 12 gpm: Well water was ft. after hours pumping gpm Bore Hole Diameter. 8 in. to 90 ft., and in. to ft. WELL WATER TO BE USED AS: 5 Public water supply 8 Air conditioning 11 Injection well 1 Domestic 3 Feedlot 6 Oil field water supply 9 Dewatering 12 Other (Specify below) 2 Irrigation 4 Industrial 7 Domestic (lawn & garden) 10 Monitoring well Was a chemical/bacteriological sample submitted to Department? Yes. No. ; If yes, mo/day/yr sample was submitted Water Well Disinfected? Yes No									
5 TYPE OF BLANK CASING USED: 1 Steel 3 RMP (SR) 5 Wrought iron 8 Concrete tile CASING JOINTS: Glued. Clamped. 2 PVC 4 ABS 6 Asbestos-Cement 9 Other (specify below) Welded Blank casing diameter 5 in. to 70 ft., Dia in. to ft., Dia in. to ft. Casing height above land surface 12 in., weight 2.8 lbs./ft. Wall thickness or gauge No. Sch. 40 TYPE OF SCREEN OR PERFORATION MATERIAL: 7 PVC 10 Asbestos-cement 1 Steel 3 Stainless steel 5 Fiberglass 8 RMP (SR) 11 Other (specify) 2 Brass 4 Galvanized steel 6 Concrete tile 9 ABS 12 None used (open hole) SCREEN OR PERFORATION OPENINGS ARE: 5 Gauzed wrapped 8 Saw cut 11 None (open hole) 1 Continuous slot 3 Mill slot 6 Wire wrapped 9 Drilled holes 2 Louvered shutter 4 Key punched 7 Torch cut 10 Other (specify) ft. SCREEN-PERFORATED INTERVALS: From 70 ft. to 90 ft., From ft. to ft. GRAVEL PACK INTERVALS: From 20 ft. to 90 ft., From ft. to ft. From ft. to ft., From ft. to ft.									
6 GROUT MATERIAL: 1 Neat cement 2 Cement grout 3 Bentonite 4 Other Grout Intervals: From 0 ft. to 20 ft., From ft. to ft., From ft. to ft. What is the nearest source of possible contamination: 1 Septic tank 4 Lateral lines 7 Pit privy 10 Livestock pens 14 Abandoned water well 2 Sewer lines 5 Cess pool 8 Sewage lagoon 11 Fuel storage 15 Oil well/Gas well 3 Watertight sewer lines 6 Seepage pit 9 Feedyard 12 Fertilizer storage 16 Other (specify below) Direction from well? West How many feet? 60									
7 CONTRACTOR'S OR LANDOWNER'S CERTIFICATION: This water well was (1) constructed, (2) reconstructed, or (3) plugged under my jurisdiction and was completed on (mo/day/year) 04/11/03 and this record is true to the best of my knowledge and belief. Kansas Water Well Contractor's Licence No. 186 This Water Well Record was completed on (mo/day/yr) 04/21/03 under the business name of Kelly's Water Well Service, Inc. by (signature) Kathryn L. Hood									
INSTRUCTIONS: Use typewriter or ball point pen. PLEASE PRESS FIRMLY and PRINT clearly. Please fill in blanks, underline or circle the correct answers. Send top three copies to Kansas Department of Health and Environment, Bureau of Water, Topeka, Kansas 66620-0001. Telephone 785-296-5524. Send one to WATER WELL OWNER and retain one for your records. Fee of \$5.00 for each constructed well.									