


WATER WELL RECORD Form WWC-5 KSA 82a-1212

Distance and direction from nearest town or city street address of well if located within city?

2	WATER WELL OWNER:	Alta Eberley	Red Tiger	Eberley No. 2
---	-------------------	--------------	-----------	---------------

3	LOCATE WELL'S LOCATION WITH	4	DEPTH OF COMPLETED WELL	220	#	ELEVATION:	Unknown
---	-----------------------------	---	-------------------------	-----	---	------------	---------

WELL'S STATIC WATER LEVEL 123 ft. below land surface measured on mo/day/yr 11 ~~12~~/4/83

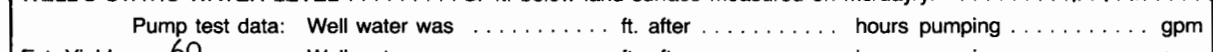

WELL WATER TO BE USED AS:	5 Public water supply	8 Air conditioning	11 Injection well
---------------------------	-----------------------	--------------------	-------------------

Was a chemical/bacteriological sample submitted to Department? Yes ☐ No ☐ : If yes, mo/day/yr sample was sub

5	TYPE OF BLANK CASING USED:	5 Wrought iron	8 Concrete tile	CASING JOINTS: <u>Glued</u> Clamped
---	----------------------------	----------------	-----------------	---

Blank casing diameter	5	in to	200	ft Dia	in to	ft Dia	in to	ft
-----------------------	---	-------	-----	--------	-------	--------	-------	----

TYPE OF SCREEN OR PERFORATION MATERIAL: 7 PVC 10 Asbestos-cement

SCREEN OR PERFORATION OPENINGS ARE:

2 Louvered shutter 4 Key punched 7 Torch cut 10 Other (specify)

GRAVEL PACK INTERVALS: From 10 ft to 220 ft From ft to ft

6 GROUT MATERIAL: 1 ~~Neak Cement~~ 2 Cement grout 3 Bentonite 4 Other

What is the nearest source of possible contamination: 10 Livestock pens 14 Abandoned water well

2 Sewer lines	5 Seepage pit	8 Sewage lagoons	12 Fertilizer storage	15 Other (specify below)
3 Watertight sewer lines	6 Seepage pit	9 Feedyard	13 Insecticide storage	

FROM	TO	LITHOLOGIC LOG	FROM	TO	LITHOLOGIC LOG
------	----	----------------	------	----	----------------

7 CONTRACTOR'S OR LANDOWNER'S CERTIFICATION: This water well was (1) constructed (2) reconstructed, or (3) plugged under my jurisdiction and was

under the business name of Kellum Water Well Service by (signature) [Signature]

INSTRUCTIONS: Use typewriter or ball point pen, PLEASE PRESS FIRMLY and PRINT clearly. Please fill in blanks, underline or circle the correct answers. Send top three copies to Kansas Department of Health and Environment, Division of Environment, Environmental Geology Section, Topeka, KS 66620. Send one to WATER WELL OWNER and retain one for your records.