

WATER WELL RECORD


Form WWC-5

Division of Water Resources; App. No.

20100313

1 LOCATION OF WATER WELL: County: <u>Rush</u>		Fraction <u>NE 1/4 NE 1/4 SE 1/4</u>		Section Number <u>36</u>	Township Number <u>T 19 S</u>	Range Number <u>R 16 XX</u>	
Distance and direction from nearest town or city street address of well if located within city? <u>3 North, 2 1/2 West of Pawnee Rock</u>				Global Positioning Systems (decimal degrees, min. of 4 digits) Latitude: _____ Longitude: _____ Elevation: _____ Datum: _____ Data Collection Method: _____			
2 WATER WELL OWNER: <u>F G Holl</u> RR#, St. Address, Box # : <u>P.O. Box 308</u> City, State, ZIP Code : <u>Ellinwood, Ks. 67526</u>							
3 LOCATE WELL'S LOCATION WITH AN "X" IN SECTION BOX: <div style="display: flex; align-items: center; justify-content: center;"> <div style="margin-right: 10px;">W</div> <table border="1" style="border-collapse: collapse; text-align: center;"> <tr> <td style="padding: 5px;">-- NW --</td> <td style="padding: 5px;">-- NE --</td> </tr> <tr> <td style="padding: 5px;">-- SW --</td> <td style="padding: 5px;">-- SE --</td> </tr> </table> <div style="margin-left: 10px;">E</div> </div> <div style="text-align: center; margin-top: 5px;">S</div>							-- NW --
-- NW --	-- NE --						
-- SW --	-- SE --						
4 DEPTH OF COMPLETED WELL <u>120</u> ft. Depth(s) Groundwater Encountered (1)..... ft. (2)..... ft. (3)..... ft. WELL'S STATIC WATER LEVEL..... <u>26</u> ft. below land surface measured on mo/day/yr... <u>7-31-10</u> .. Pump test data: Well water was.....ft. after..... hours pumping..... gpm Est. Yield.. <u>N/A</u> ..gpm: Well water was.....ft. after..... hours pumping..... gpm WELL WATER TO BE USED AS: 5 Public water supply 8 Air conditioning 11 Injection well 1 Domestic 3 Feedlot 6 <u>Oil field water supply</u> 9 Dewatering 12 Other (Specify below) 2 Irrigation 4 Industrial 7 Domestic (lawn & garden) 10 Monitoring well Was a chemical/bacteriological sample submitted to Department? Yes No <u>X</u> ...; If yes, mo/day/yr Sample was submitted..... Water well disinfected? Yes <u>HTH</u> .. No							
5 TYPE OF CASING USED: 5 Wrought Iron 8 Concrete tile CASING JOINTS: Glued..... <u>X</u> .. Clamped..... 1 Steel 3 RMP (SR) 6 Asbestos-Cement 9 Other (specify below) Welded..... 2 PVC 4 ABS 7 Fiberglass Threaded..... Blank casing diameter <u>5</u> in. to <u>60</u> ft., Diameter. in. to ft., Diameter in. to ft. Casing height above land surface..... <u>24</u> in., Weight ... <u>SDR-26</u> ...lbs./ft. Wall thickness or gauge No. TYPE OF SCREEN OR PERFORATION MATERIAL: 1 Steel 3 Stainless Steel 5 Fiberglass 7 <u>PVC</u> 9 ABS 11 Other (Specify) 2 Brass 4 Galvanized Steel 6 Concrete tile 8 RM (SR) 10 Asbestos-Cement 12 None used (open hole) SCREEN OR PERFORATION OPENINGS ARE: 1 Continuous slot 3 Mill slot 5 Gauzed wrapped 7 Torch cut 9 Drilled holes 11 None (open hole) 2 Louvered shutter 4 Key punched 6 Wire wrapped 8 <u>Saw cut</u> 10 Other (specify) SCREEN-PERFORATED INTERVALS: From..... <u>120</u> ft. to <u>60</u> ft., From ft. to ft. From..... ft. to ft., From ft. to ft. GRAVEL PACK INTERVALS: From..... <u>120</u> ft. to <u>20</u> ft., From ft. to ft. From..... ft. to ft., From ft. to ft.							
6 GROUT MATERIAL: 1 Neat cement 2 Cement grout 3 Bentonite 4 Other <u>hole plug</u> Grout Intervals: From ft. to ft., From ft. to ft., From <u>20</u> ft. to <u>0</u> ft. What is the nearest source of possible contamination: 1 Septic tank 4 Lateral lines 7 Pit privy 10 Livestock pens 13 Insecticide storage 16 Other (specify below) 2 Sewer lines 5 Cess pool 8 Sewage lagoon 11 Fuel storage 14 Abandoned water well 3 Watertight sewer lines 6 Seepage pit 9 Feedyard 12 Fertilizer storage 15 Oil well/gas well <u>None</u> Direction from well? How many feet?							
FROM	TO	LITHOLOGIC LOG	FROM	TO	PLUGGING INTERVALS		
0	42	Clay					
42	51	Clay & very soft sandstone					
51	73	Clay					
73	89	Soft sandstone					
89	97	Clay					
97	116	Dakota Drift					
116	120	Fire clay					
7 CONTRACTOR'S OR LANDOWNER'S CERTIFICATION: This water well was (1) <u>constructed</u> , (2) reconstructed, or (3) plugged under my jurisdiction and was completed on (mo/day/year) <u>7-31-10</u> ... and this record is true to the best of my knowledge and belief. Kansas Water Well Contractor's License No. ... <u>134</u> This Water Well Record was completed on (mo/day/year) ... <u>8-11-10</u> under the business name of <u>Rosencrantz- Bemis</u> by (signature) <u>[Signature]</u>							
INSTRUCTIONS: Use typewriter or ball point pen. <u>PLEASE PRESS FIRMLY</u> and <u>PRINT</u> clearly. Please fill in blanks, underline or circle the correct answers. Send top three copies to Kansas Department of Health and Environment, Bureau of Water, Geology Section, 1000 SW Jackson St., Suite 420, Topeka, Kansas 66612-1367. Telephone 785-296-5522. Send one to WATER WELL OWNER and retain one for your records. Fee of \$5.00 for each <u>constructed</u> well. Visit us at http://www.kdheks.gov/waterwell/index.html .							

ASSIGNMENT OF WATER WELL TO LANDOWNER

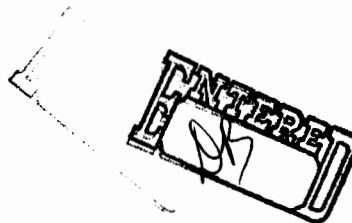

PERMIT NO.- 20100313

This agreement between FG Holl Co. P.O. Box 308 Ellinwood, Ks.
(Operator name and address)

and Mrs. William Werhahn 2525 Dry Creek Great Bend
(Landowner name and address)

certifies that said Landowner hereby accepts the water well drilled as a temporary source of water for an oil well drilled for Operator located approximately NE/NE1SE in Section 36 Township 19 Range 16 of Rush County, Kansas. Landowner hereby agrees that said water well will be for domestic use only and when no longer needed, agrees to plug the water well in accordance with the State Regulation KAR 28-30-7.

Signed this 22 day of FEB, 2011

OPERATOR:

FG Holl

By: Steve H. Steyer
Agent

LANDOWNER:

Mrs. William Werhahn

Mrs William Werhahn
Signature