

ASSIGNMENT OF WATER WELL TO LANDOWNER

PERMIT NO.- 20110021

This agreement between FG Holl P.O. Box 308 Ellinwood, Ks.
(Operator name and address)

and Gerald Oetken Rt 1 Box 47 Larned, Ks. 67550
(Landowner name and address)

certifies that said Landowner hereby accepts the water well drilled as a temporary source of water for an oil well drilled for Operator located approximately C/32/S2/SE in Section 32 Township 19 Range 16 of Rush County, Kansas. Landowner hereby agrees that said water well will be for domestic use only and when no longer needed, agrees to plug the water well in accordance with the State Regulation KAR 28-30-7.

Signed this 27 day of July, 2011

OPERATOR:
FG Holl

By: Steve Stevens
Agent

LANDOWNER:
Gerald Oetken

[Signature]
Signature

WATER WELL RECORD

Form WWC-5

Division of Water Resources App. No.


20110021

1 LOCATION OF WATER WELL: County: Rush	Fraction C ¼ S2 ¼ S2 ¼ SE ¼	Section Number 32	Township No. T 19 S	Range Number R 16 <input type="checkbox"/> E <input checked="" type="checkbox"/> W
--	--------------------------------	----------------------	------------------------	---

Street/Rural Address of Well Location; if unknown, distance & direction from nearest town or intersection: If at owner's address, check here .
8 south & 1 1/4 west of Schaffer

Global Positioning System (GPS) information:
Latitude: (in decimal degrees)
Longitude: (in decimal degrees)
Elevation:
Datum: WGS 84, NAD 83, NAD 27
Collection Method:
 GPS unit (Make/Model:)
 Digital Map/Photo, Topographic Map, Land Survey
Est. Accuracy: <3 m, 3-5 m, 5-15 m, >15 m

2 WATER WELL OWNER: F.G. Holl
RR#, Street Address, Box #: P.O. Box 308
City, State, ZIP Code : Ellinwood, Ks. 67526

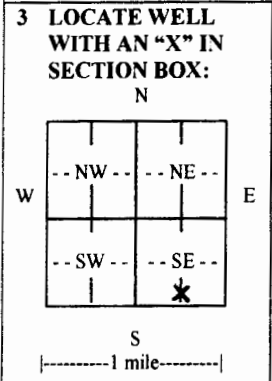

4 DEPTH OF COMPLETED WELL 85 ft.
Depth(s) Groundwater Encountered (1)..... ft. (2)..... ft. (3)..... ft.
WELL'S STATIC WATER LEVEL 43ft. below land surface measured on mo/day/yr. 1:18:11.....
Pump test data: Well water was.....ft. after..... hours pumping..... gpm
EST. YIELD. NA.....gpm. Well water was.....ft. after..... hours pumping..... gpm
Bore Hole Diameter 10.....in. to .85.....ft., and.....in. toft.
WELL WATER TO BE USED AS: Public water supply Geothermal Injection well
 Domestic Feedlot Oil field water supply Dewatering Other (Specify below)
 Irrigation Industrial Domestic-lawn & garden Monitoring well
Was a chemical/bacteriological sample submitted to Department? Yes No
If yes, mo/day/yr sample was submitted.....
Water well disinfected? Yes No

5 TYPE OF CASING USED: Steel PVC Other
CASING JOINTS: Glued Clamped Welded Threaded
Casing diameter .5..... in. to .85..... ft., Diameter in. to ft., Diameter in. to ft.
Casing height above land surface .18..... in., Weight SDR.26.....lbs./ft., Wall thickness or gauge No.
TYPE OF SCREEN OR PERFORATION MATERIAL:
 Steel Stainless Steel PVC Other (Specify)
 Brass Galvanized Steel None used (open hole)
SCREEN OR PERFORATION OPENINGS ARE:
 Continuous slot Mill slot Gauze wrapped Torch cut Drilled holes None (open hole)
 Louvered shutter Key punched Wire wrapped Saw cut Other (specify)
SCREEN-PERFORATED INTERVALS: From .85..... ft. to .55..... ft., From ft. to ft.
From..... ft. to ft., From ft. to ft.
GRAVEL PACK INTERVALS: From .85..... ft. to .20..... ft., From ft. to ft.
From..... ft. to ft., From ft. to ft.

6 GROUT MATERIAL: Neat cement Cement grout Bentonite Other
Grout Intervals: From ft. to ft., From .20..... ft. to 0..... ft., From ft. to ft.
What is the nearest source of possible contamination:
 Septic tank Lateral lines Pit privy Livestock pens Insecticide storage Other (specify below)
 Sewer lines Cesspool Sewage lagoon Fuel storage Abandoned water well
 Watertight sewer lines Seepage pit Feedyard Fertilizer storage Oil well/gas well None
Direction from well Distance from well

FROM	TO	LITHOLOGIC LOG	FROM	TO	LITHO. LOG (cont.) or PLUGGING INTERVALS
0	42	Tan clay			
42	64	Tan silty clay			
64	77	Sandstone-soft			
77	85	Gray, yellow & red shale			

7 CONTRACTOR'S OR LANDOWNER'S CERTIFICATION: This water well was constructed, reconstructed, or plugged under my jurisdiction and was completed on (mo/day/year) 1:18:11..... and this record is true to the best of my knowledge and belief.
Kansas Water Well Contractor's License No. 134..... This Water Well Record was completed on (mo/day/year) 1:24:11.....
under the business name of Rosenkrantz-Bemis..... by (signature) [Signature].....

INSTRUCTIONS: Use typewriter or ball point pen. PLEASE PRESS FIRMLY and PRINT clearly. Please fill in blanks and check the correct answers. Send three copies (white, blue, pink) to Kansas Department of Health and Environment, Bureau of Water, Geology Section, 1000 SW Jackson St., Suite 420, Topeka, Kansas 66612-1367. Telephone 785-296-5522. Send one copy to WATER WELL OWNER and retain one for your records. Include fee of \$5.00 for each constructed well. Visit us at <http://www.kdheks.gov/waterwell/index.html>.