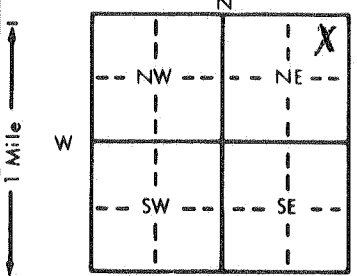


1 LOCATION OF WATER WELL: Fraction Section Number Township Number Range Number  
 County: Rush ne 1/4 ne 1/4 ne 1/4 14 T 19 S R 16 W

Distance and direction from nearest town or city street address of well if located within city?

4 3/4 south -1 3/4 east of Schaffer

2 WATER WELL OWNER: Dellane Oetken  
 RR#, St. Address, Box #: Albert, Ks. 67511 Board of Agriculture, Division of Water Resources  
 City, State, ZIP Code: Application Number:

3 LOCATE WELL'S LOCATION WITH AN "X" IN SECTION BOX:  
  
 4 DEPTH OF COMPLETED WELL... 140... ft. ELEVATION:  
 Depth(s) Groundwater Encountered 1... ft. 2... ft. 3... ft.  
 WELL'S STATIC WATER LEVEL... 70... ft. below land surface measured on mo/day/yr... 3-22-88...  
 Pump test data: Well water was... ft. after... hours pumping... gpm  
 Est. Yield... NA... gpm: Well water was... ft. after... hours pumping... gpm  
 Bore Hole Diameter... 10... in. to... 140... ft., and... in. to... ft.  
 WELL WATER TO BE USED AS: 5 Public water supply 8 Air conditioning 11 Injection well  
 1 Domestic 3 Feedlot 6 Oil field water supply 9 Dewatering 12 Other (Specify below)  
 2 Irrigation 4 Industrial 7 Lawn and garden only 10 Observation well  
 Was a chemical/bacteriological sample submitted to Department? Yes... No... X...; If yes, mo/day/yr sample was submitted  
 Water Well Disinfected? Yes hth No

5 TYPE OF BLANK CASING USED:  
 1 Steel 3 RMP (SR) 5 Wrought iron 8 Concrete tile CASING JOINTS: Glued... X... Clamped...  
 2 PVC 4 ABS 6 Asbestos-Cement 9 Other (specify below) Welded...  
 7 Fiberglass Threaded...  
 Blank casing diameter... 5... in. to... 120... ft., Dia... in. to... ft., Dia... in. to... ft.  
 Casing height above land surface... 2... ft., weight... lbs./ft. Wall thickness or gauge No... 258  
 TYPE OF SCREEN OR PERFORATION MATERIAL:  
 1 Steel 3 Stainless steel 5 Fiberglass 8 RMP (SR) 10 Asbestos-cement  
 2 Brass 4 Galvanized steel 6 Concrete tile 9 ABS 11 Other (specify)  
 12 None used (open hole)  
 SCREEN OR PERFORATION OPENINGS ARE:  
 1 Continuous slot 3 Mill slot 5 Gauzed wrapped 8 Saw cut 11 None (open hole)  
 2 Louvered shutter 4 Key punched 6 Wire wrapped 9 Drilled holes  
 7 Torch cut 10 Other (specify)  
 SCREEN-PERFORATED INTERVALS: From... 120... ft. to... 140... ft., From... ft. to... ft.  
 GRAVEL PACK INTERVALS: From... 22... ft. to... 140... ft., From... ft. to... ft.

6 GROUT MATERIAL: 1 Neat cement 2 Cement grout 3 Bentonite 4 Other  
 Grout Intervals: From... 0... ft. to... 22... ft., From... ft. to... ft., From... ft. to... ft.  
 What is the nearest source of possible contamination:  
 1 Septic tank 4 Lateral lines 7 Pit privy 10 Livestock pens 14 Abandoned water well  
 2 Sewer lines 5 Cess pool 8 Sewage lagoon 11 Fuel storage 15 Oil well/Gas well  
 3 Watertight sewer lines 6 Seepage pit 9 Feedyard 12 Fertilizer storage 16 Other (specify below)  
 13 Insecticide storage  
 Direction from well? north east How many feet? 142 1/2 ft.

FROM	TO	LITHOLOGIC LOG	FROM	TO	LITHOLOGIC LOG
0	3	Top soil			
3	22	Clay			
22	26	Rock			
26	38	Clay			
38	65	Shale			
65	90	Shale rock			
90	102	White clay			
102	110	Fire clay			
110	116	Shale some rock			
116	140	Good clean sand rock			

7 CONTRACTOR'S OR LANDOWNER'S CERTIFICATION: This water well was (1) constructed, (2) reconstructed, or (3) plugged under my jurisdiction and was completed on (mo/day/year) 3-22-88 and this record is true to the best of my knowledge and belief. Kansas Water Well Contractor's License No. 134 This Water Well Record was completed on (mo/day/yr) 7-1-88 under the business name of Rosencrantz-Beris by (signature) Media Rodson

INSTRUCTIONS: Use typewriter or ball point pen. PLEASE PRESS FIRMLY and PRINT clearly. Please fill in blanks, underline or circle the correct answers. Send top three copies to Kansas Department of Health and Environment, Office of Oil Field and Environmental Geology, Regulation and Permitting Section, Topeka, Kansas 66620-7500, Telephone: 913-862-9360. Send one to WATER WELL OWNER and retain one for your records.