


1 LOCATION OF WATER WELL: Fraction SE NW NW Section Number 23 Township Number 19 S Range Number 17  
 County: Rush EW

Distance and direction from nearest town or city street address of well if located within city?  
Ave V + CR 320 - east 500' South 300'

2 WATER WELL OWNER: LARRY STEJSKA  
 RR #, St. Address, Box #: RR 2 Box 8290 Board of Agriculture, Division of Water Resources  
 City, State, ZIP Code: TIMKEN KS 67575 Application Number: \_\_\_\_\_

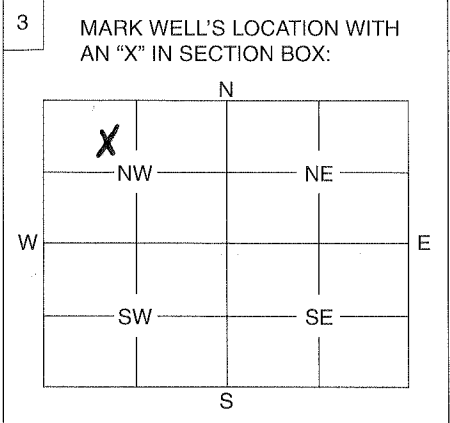

4 DEPTH OF WELL 177 ft.  
 WELL'S STATIC WATER LEVEL 52 ft.  
 WELL WAS USED AS:  
 1 Domestic      5 Public Water Supply      9 Dewatering  
 2 Irrigation      6 Oil Field Water Supply      10 Monitoring Well  
 3 Feedlot      7 Domestic (Lawn & Garden)      11 Injection Well  
 4 Industrial      8 Air Conditioning      12 Other .....

Was a chemical / bacteriological sample submitted to Department? Yes ..... No  .....  
 If yes, mo/day/yr sample was submitted .....

Water Well Disinfected: Yes  No .....

5 TYPE OF BLANK CASING USED:  
 1 Steel      3 RMP (SR)      5 Wrought      7 Fiberglass      9 Other (Specify below)  
 2 PVC      4 ABS      6 Asbestos-Cement      8 Concrete Tile

Blank casing diameter 5 in. Was casing pulled? Yes ..... No  ..... If yes, how much .....

Casing height above or below land surface 36 in.

6 GROUT PLUG MATERIAL: 1 Neat cement      2 Cement grout       3 Bentonite      4 Other .....

Grout Plug Intervals: From 24 ft. to 3 ft., From ..... ft. to ..... ft., From ..... to ..... ft.

What is the nearest source of possible contamination:  
 1 Septic tank      6 Seepage pit      11 Fuel storage      16 Other (specify below)  
 2 Sewer lines      7 Pit privy      12 Fertilizer storage  
 3 Watertight sewer lines      8 Sewage lagoon      13 Insecticide storage  
 4 Lateral lines      9 Feedyard      14 Abandoned water well  
 5 Cess pool      10 Livestock pens      15 Oil well/Gas well

Direction from well? ..... How many feet? .....

FROM	TO	PLUGGING MATERIALS
177	125	Gravel
125	24	CLAY
24	3	Bentonite
3	0	Topsoil

7 CONTRACTOR'S OR LANDOWNER'S CERTIFICATION: This water well was plugged under my jurisdiction and was completed on (mo/day/year) 9-19-10 and this record is true to the best of my knowledge and belief. Kansas Water Well Contractor's License No. 624 This Water Well Record was completed on (mo/day/year) 10-3-10 under the business name of Town & Country Water Well by (signature) Al Ru

INSTRUCTIONS: Use typewriter or ball point pen. Please press firmly and print clearly. Please fill in blanks, underline or circle the correct answers. Send top three copies to Kansas Department of Health and Environment, Bureau of Water, Geology Section, 1000 SW Jackson St., Ste. 420, Topeka, Kansas 66612-1367. Telephone: 785/296-5522. Send one to Water Well Owner and retain one for your records.