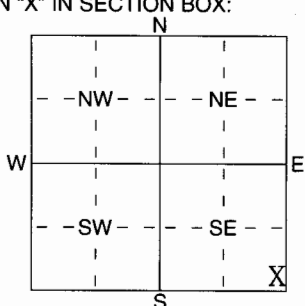


1 LOCATION OF WATER WELL: Fraction SE 1/4 SE 1/4 SE 1/4 Section Number 14 Township Number T 19 S Range Number R 18 EW
 County: Rush

Distance and direction from nearest town or city street address of well if located within city?
4 3/4 South, 2 ~~XXXXX~~ East of Rush Center

2 WATER WELL OWNER: Jamie Holoprirek
 RR#, St. Address, Box # : RR 1 Box 94 Board of Agriculture, Division of Water Resources
 City, State, ZIP Code : Seneca, Ks. 66538 Application Number: RHWW2878

3 LOCATE WELL'S LOCATION WITH AN "X" IN SECTION BOX:

 4 DEPTH OF COMPLETED WELL 290 ft. ELEVATION:
 Depth(s) Groundwater Encountered 1 ft. 2 ft. 3 ft.
 WELL'S STATIC WATER LEVEL 190 ft. below land surface measured on 5-6-05
 Pump test data: Well water was ft. after hours pumping gpm
 Est. Yield N/A gpm: Well water was ft. after hours pumping gpm
 WELL WATER TO BE USED AS: 5 Public water supply 8 Air conditioning 11 Injection well
 1 Domestic 3 Feedlot 6 Oil field water supply 9 Dewatering 12 Other (Specify below)
 2 Irrigation 4 Industrial 7 Domestic (lawn & garden) 10 Monitoring well Stock
 Was a chemical/bacteriological sample submitted to Department? Yes No X If yes, mo/day/yr sample was submitted
 Water Well Disinfected? Yes HTH No

5 TYPE OF BLANK CASING USED: 5 Wrought iron 8 Concrete tile CASING JOINTS: Glued X Clamped
 1 Steel 3 RMP (SR) 6 Asbestos-Cement 9 Other (specify below) Welded
 2 PVC 4 ABS 7 Fiberglass Threaded
 Blank casing diameter 5 in. to ft., Dia in. to ft., Dia 5 in. to 200 ft.
 Casing height above land surface 12 in., weight SDR-17 lbs./ft. Wall thickness or gauge No. SDR21
 TYPE OF SCREEN OR PERFORATION MATERIAL: 7 PVC 10 Asbestos-Cement
 1 Steel 3 Stainless Steel 5 Fiberglass 8 RMP (SR) 11 Other (Specify)
 2 Brass 4 Galvanized Steel 6 Concrete tile 9 ABS 12 None used (open hole)
 SCREEN OR PERFORATION OPENINGS ARE: 5 Guazed wrapped 8 Saw cut 11 None (open hole)
 1 Continuous slot 3 Mill slot 6 Wire wrapped 9 Drilled holes
 2 Louvered shutter 4 Key punched 7 Torch cut 10 Other (specify) ft.
 SCREEN-PERFORATED INTERVALS: From 280 ft. to 200 ft., From ft. to ft.
 GRAVEL PACK INTERVALS: From 290 ft. to 20 ft., From ft. to ft.
 From ft. to ft., From ft. to ft.

6 GROUT MATERIAL: 1 Neat cement 2 Cement grout 3 Bentonite 4 Other hole plug
 Grout Intervals: From 20 ft. to 0 ft., From ft. to ft., From ft. to ft.
 What is the nearest source of possible contamination:
 1 Septic tank 4 Lateral lines 7 Pit privy 10 Livestock pens 14 Abandoned water well
 2 Sewer lines 5 Cess pool 8 Sewage lagoon 11 Fuel storage 15 Oil well/Gas well
 3 Watertight sewer lines 6 Seepage pit 9 Feedyard 12 Fertilizer storage 16 Other (specify below)
 Direction from well? How many feet?
 13 Insecticide storage None

FROM	TO	LITHOLOGIC LOG	FROM	TO	PLUGGING INTERVALS
0	5	Top soil	190	195	Light gray shell XXXX with fire clay
5	19	Tan clay	195	215	Gray shell
19	20	Rock	215	220	Fire clay
20	23	Tan clay	220	240	Light gray shell
23	105	Gray shell- brittle with rock- hard, dry	240	251	Light gray shell, streaks of sandstone
105	115	Gray shell, brittle with streaks of rock	251	270	Gray shell
115	125	Gray shell with quartz	270	290	Gray shell with streaks of fire clay
125	150	Gray shell- dark			
150	157	Light gray shell			
157	175	Med color gray shell			
175	185	Light gray shell- hard, silty			
185	190	Light gray shell			

7 CONTRACTOR'S OR LANDOWNER'S CERTIFICATION: This water well was (1) constructed, (2) reconstructed, or (3) plugged under my jurisdiction and was completed on (mo/day/year) 6-3-05 and this record is true to the best of my knowledge and belief. Kansas Water Well Contractor's Licence No 134 This Water Well Record was completed on (mo/day/yr) 6-6-05 under the business name of Rosencrantz- Bemis by (signature) [Signature]