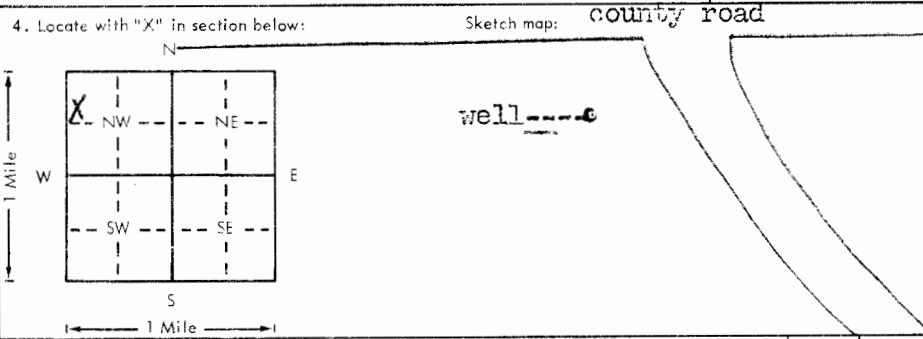


USE TYPEWRITER OR BALL POINT PEN—PRESS FIRMLY, PRINT CLEARLY.

WATER WELL RECORD
KSA 82a-1201-1215

Kansas Department of Health and Environment—Division of Environment
(Water well Contractors)
Topeka, Kansas 66620

1. Location of well:		County Rush	Fraction SW 1/4 NW 1/4 NW 1/4	Section number 23	Township number T 19 S R 18 E W	Range number 18 E W
2. Distance and direction from nearest town or city: 5 miles, south 1 east Rush Center, Ks. Street address of well location if in city:				3. Owner of well: Rich Petrick R.R. or street: RR Rush Center, Ks. City, state, zip code:		
4. Locate with "X" in section below: 				6. Bore hole dia. 8 in. Completion date 9-21-79 Well depth 140 ft.		
				7. <input type="checkbox"/> Cable tool <input checked="" type="checkbox"/> Rotary <input type="checkbox"/> Driven <input type="checkbox"/> Dug <input type="checkbox"/> Hollow rod <input type="checkbox"/> Jetted <input type="checkbox"/> Bored <input type="checkbox"/> Reverse rotary		
				8. Use: <input type="checkbox"/> Domestic <input type="checkbox"/> Public supply <input type="checkbox"/> Industry <input type="checkbox"/> Irrigation <input type="checkbox"/> Air conditioning <input checked="" type="checkbox"/> Stock <input type="checkbox"/> Lawn <input type="checkbox"/> Oil field water <input type="checkbox"/> Other		
				9. Casing: Material pvc Height: Above or below Threaded <input type="checkbox"/> Welded <input checked="" type="checkbox"/> Surface 16 in. RMP <input type="checkbox"/> PVC <input checked="" type="checkbox"/> Weight 200 lbs./ft. Dia. 5 in. to 140 ft. depth Wall Thickness: inches or Dia. <input type="checkbox"/> in. to <input type="checkbox"/> ft. depth gage No. .26		
5. Type and color of material				From	To	10. Screen manufacturer's name Jet stream
topsoil				0	4	Type pvc Dia. 5
clay				4	52	Slot .031 Length 20
shale				52	104	Set between 120 ft. and 140 ft.
white dakota clay				104	118	Gravel pack? <input checked="" type="checkbox"/> Size range of material 2-10
white dakota clay with streaks of sandstone				118	140	11. Static water level: 110 ft. below land surface Date 9-21-79 mo./day/yr.
						12. Pumping level below land surfaces: 120 ft. after 2 hrs. pumping 5 g.p.m. ft. after hrs. pumping g.p.m. Estimated maximum yield 5 g.p.m.
						13. Water sample submitted: mo./day/yr. Yes <input checked="" type="checkbox"/> No <input type="checkbox"/> Date
						14. Well head completion: 16 inches above grade <input type="checkbox"/> Pitless adapter
						15. Well grouted? <input checked="" type="checkbox"/> With: <input checked="" type="checkbox"/> Neat cement <input type="checkbox"/> Bentonite <input type="checkbox"/> Concrete Depth: From 0 ft. to 10 ft.
						16. Nearest source of possible contamination: none ft. Direction Type Well disinfected upon completion? <input checked="" type="checkbox"/> Yes <input type="checkbox"/> No
						17. Pump: <input checked="" type="checkbox"/> Not installed Manufacturer's name Model number HP Volts Length of drop pipe ft. capacity g.p.m. Type: <input type="checkbox"/> Submersible <input type="checkbox"/> Turbine <input type="checkbox"/> Jet <input type="checkbox"/> Reciprocating <input type="checkbox"/> Centrifugal <input type="checkbox"/> Other
				(Use a second sheet if needed)		
18. Elevation:		19. Remarks:		20. Water well contractor's certification: This well was drilled under my jurisdiction and this report is true to the best of my knowledge and belief. karst Water Well 199 Business name E. Hiway 40 Hays, Ks. License No. Address 1414 W 14th St Signed [Signature] Date 9-21-79 Authorized representative		
Topography: <input checked="" type="checkbox"/> Hill <input type="checkbox"/> Slope <input type="checkbox"/> Upland <input type="checkbox"/> Valley						

T 19 S R 18 E W Sec 23 SW 1/4 NW 1/4

Forward the white, blue and pink copies to the Department of Health and Environment

Form WWC-5