


1 LOCATION OF WATER WELL: Fraction Ne 1/4 NW 1/4 Ne 1/4 Section Number 29 Township Number T 19 S Range Number R 2 E
 County: Mepherson

Distance and direction from nearest town or city street address of well if located within city?

1 1/2 W Galva

2 WATER WELL OWNER: Gaylen Begehe
 RR#, St. Address, Box #: RR 4 Box 27A
 City, State, ZIP Code: Galva, KS 67443
 Board of Agriculture, Division of Water Resources
 Application Number:

3 LOCATE WELL'S LOCATION WITH AN "X" IN SECTION BOX:

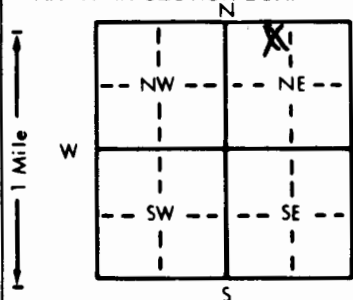

4 DEPTH OF COMPLETED WELL: 20 ft. ELEVATION: 7-3-95
 Depth(s) Groundwater Encountered 1 ft. 2. 35 ft. 3. 7-3-95 ft.
 WELL'S STATIC WATER LEVEL 21 ft. below land surface measured on mo/day/yr 7-3-95

Pump test data: Well water was 20 ft. after 9 hours pumping 20 gpm
 Est. Yield 20 gpm Well water was 20 ft. after 9 hours pumping 20 gpm
 Bore Hole Diameter 9 in. to 20 ft. and 20 in. to 20 ft.

WELL WATER TO BE USED AS:
 1 Domestic 3 Feedlot 6 Oil field water supply 9 Dewatering 12 Other (Specify below)
 2 Irrigation 4 Industrial 7 Lawn and garden only 10 Monitoring well

5 Public water supply 8 Air conditioning 11 Injection well
 Was a chemical/bacteriological sample submitted to Department? Yes X No X; If yes, mo/day/yr sample was submitted

Water Well Disinfected? Yes X No

5 TYPE OF BLANK CASING USED:

1 Steel 3 RMP (SR) 5 Wrought iron 8 Concrete tile CASING JOINTS: Glued X Clamped
 2 PVC 4 ABS 6 Asbestos-Cement 9 Other (specify below) Welded
 7 Fiberglass Threaded

Blank casing diameter 5 in. to 35 ft. Dia 12 in. to 16 ft. Dia 214 in. to 214 ft.
 Casing height above land surface 12 in. weight 12 lbs./ft. Wall thickness or gauge No. 214

TYPE OF SCREEN OR PERFORATION MATERIAL:

1 Steel 3 Stainless steel 5 Fiberglass 8 RMP (SR) 10 Asbestos-cement
 2 Brass 4 Galvanized steel 6 Concrete tile 9 ABS 11 Other (specify)
 12 None used (open hole)

SCREEN OR PERFORATION OPENINGS ARE:

1 Continuous slot 3 Mill slot 5 Gauzed wrapped 8 Saw cut 11 None (open hole)
 2 Louvered shutter 4 Key punched 6 Wire wrapped 9 Drilled holes
 7 Torch cut 10 Other (specify)

SCREEN-PERFORATED INTERVALS: From 35 ft. to 60 ft. From 35 ft. to 60 ft.
 From 30 ft. to 80 ft. From 30 ft. to 80 ft.

GRAVEL PACK INTERVALS: From 30 ft. to 80 ft. From 30 ft. to 80 ft.

6 GROUT MATERIAL:

1 Neat cement 2 Cement grout 3 Bentonite 4 Other
 Grout Intervals: From 0 ft. to 20 ft. From 20 ft. to 300 ft.

What is the nearest source of possible contamination:

1 Septic tank 4 Lateral lines 7 Pit privy 10 Livestock pens 14 Abandoned water well
 2 Sewer lines 5 Cess pool 8 Sewage lagoon 11 Fuel storage 15 Oil well/Gas well
 3 Watertight sewer lines 6 Seepage pit 9 Feedyard 12 Fertilizer storage 16 Other (specify below)
 13 Insecticide storage

Direction from well? N How many feet? 300 +

FROM TO LITHOLOGIC LOG FROM TO PLUGGING INTERVALS

0 28 Clay

28 32 Fine Sand

32 40 Sand & mixed Clay

40 60 Yellow Clay

60 80 Red Clay & Shale

7 CONTRACTOR'S OR LANDOWNER'S CERTIFICATION: This water well was (1) constructed, (2) reconstructed, or (3) plugged under my jurisdiction and was completed on (mo/day/year) 7-3-95 and this record is true to the best of my knowledge and belief. Kansas

Water Well Contractor's License No. 180 This Water Well Record was completed on (mo/day/yr) 7-12-95
 under the business name of Backhus Drilling by (signature) Frank H. Backhus