

**CORRECTION(S) TO WATER WELL RECORD (WWC-5)**

(to rectify lacking or incorrect information)

**Location listed as:**

Section-Township-Range: 27-195-2W

Fraction (  $\frac{1}{4}$   $\frac{1}{4}$   $\frac{1}{4}$ ): NE NW NW

County: McPherson

**Location changed to:**

13-195-2W

SE SE SW SW

**Other changes:** Initial statements: \_\_\_\_\_

Changed to: \_\_\_\_\_

Comments: Latitude: 38.39161° N, Longitude: -97.49572° W

verification method: Letter and corrections from KCC, lat./long.,  
and Galva & Canton 1:24,000 topo. maps.

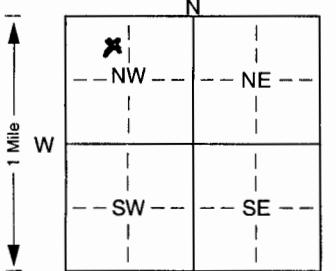
initials: DRJ date: 11/28/2005

submitted by: Kansas Geological Survey, Data Resources Library, 1930 Constant Ave., Lawrence, KS 66047-3726  
to: Kansas Dept of Health & Environment, Bureau of Water, 1000 SW Jackson, Suite 420, Topeka, KS 66612-1367.

1 LOCATION OF WATER WELL: Fraction NE 1/4 NW 1/4 NW 1/4 Section Number 24 Township Number T 19 S R 2 Range Number 2 County: McPherson

Distance and direction from nearest town or city street address of well if located within city?  
1 mile east of Galva, KS 1 mile north 1 1/4 miles east well on N. side of Road

2 WATER WELL OWNER: KANSAS CORPORATION COMMISSION DISTRICT #2  
 RR#, St. Address, Box #: 130 SOUTH MARKET ST RM 2125 Board of Agriculture, Division of Water Resources  
 City, State, ZIP Code: Wichita, KS 67202-3802 Application Number:

3 LOCATE WELL'S LOCATION WITH AN "X" IN SECTION BOX:  4 DEPTH OF COMPLETED WELL: 85 ft. ELEVATION: \_\_\_\_\_ ft.  
 Depth(s) Groundwater Encountered 1. \_\_\_\_\_ ft. 2. \_\_\_\_\_ ft. 3. \_\_\_\_\_ ft.  
 WELL'S STATIC WATER LEVEL \_\_\_\_\_ ft. below land surface measured on mo/day/yr \_\_\_\_\_  
 Pump test data: Well water was \_\_\_\_\_ ft. after \_\_\_\_\_ hours pumping \_\_\_\_\_ gpm  
 Est. Yield \_\_\_\_\_ gpm: Well water was \_\_\_\_\_ ft. after \_\_\_\_\_ hours pumping \_\_\_\_\_ gpm  
 Bore Hole Diameter: 7 1/8 in. to 8 5/8 in. and \_\_\_\_\_ in. to \_\_\_\_\_ in.  
 WELL WATER TO BE USED AS: 5 Public water supply 8 Air conditioning 11 Injection well  
 1 Domestic 3 Feedlot 6 Oil field water supply 9 Dewatering 12 Other (Specify below)  
 2 Irrigation 4 Industrial 7 Domestic (lawn & garden) 10 Monitoring well

5 TYPE OF BLANK CASING USED: 1 Steel 3 RMP (SR) 5 Wrought iron 8 Concrete tile CASING JOINTS: Glued. \_\_\_\_\_ Clamped. \_\_\_\_\_  
2 PVC 4 ABS 6 Asbestos-Cement 9 Other (specify below) Welded \_\_\_\_\_  
 7 Fiberglass Threaded. X  
 Blank casing diameter 2 in. to 7 1/2 in. Dia \_\_\_\_\_ in. to \_\_\_\_\_ in. Dia \_\_\_\_\_ in. to \_\_\_\_\_ in. Dia \_\_\_\_\_ in. to \_\_\_\_\_ in. Dia \_\_\_\_\_  
 Casing height above land surface 36 in., weight \_\_\_\_\_ lbs./ft. Wall thickness or gauge No. Sch 40  
 TYPE OF SCREEN OR PERFORATION MATERIAL: 7 PVC 10 Asbestos-cement  
 1 Steel 3 Stainless steel 5 Fiberglass 8 RMP (SR) 11 Other (specify) \_\_\_\_\_  
 2 Brass 4 Galvanized steel 6 Concrete tile 9 ABS 12 None used (open hole)  
 SCREEN OR PERFORATION OPENINGS ARE: 5 Gauzed wrapped 8 Saw cut 11 None (open hole)  
 1 Continuous slot 3 Mill slot .010 6 Wire wrapped 9 Drilled holes  
 2 Louvered shutter 4 Key punched 7 Torch cut 10 Other (specify) \_\_\_\_\_  
 SCREEN-PERFORATED INTERVALS: From 75' ft. to 85' ft. From \_\_\_\_\_ ft. to \_\_\_\_\_ ft. From \_\_\_\_\_ ft. to \_\_\_\_\_ ft. From \_\_\_\_\_ ft. to \_\_\_\_\_ ft.  
 GRAVEL PACK INTERVALS: From 90 ft. to 70 ft. From \_\_\_\_\_ ft. to \_\_\_\_\_ ft. From \_\_\_\_\_ ft. to \_\_\_\_\_ ft. From \_\_\_\_\_ ft. to \_\_\_\_\_ ft.

6 GROUT MATERIAL: 1 Neat cement 2 Cement grout 3 Bentonite 4 Other 1 Bucket of 1/2" Pellets  
 Grout Intervals: From 70 ft. to 68 ft. From 68 ft. to 3 ft. From \_\_\_\_\_ ft. to \_\_\_\_\_ ft. From \_\_\_\_\_ ft. to \_\_\_\_\_ ft.  
 What is the nearest source of possible contamination: 10 Livestock pens 14 Abandoned water well  
 1 Septic tank 4 Lateral lines 7 Pit privy 11 Fuel storage 15 Oil well/Gas well  
 2 Sewer lines 5 Cess pool 8 Sewage lagoon 12 Fertilizer storage 16 Other (specify below)  
 3 Watertight sewer lines 6 Seepage pit 9 Feedyard 13 Insecticide storage CROP FIELD  
 Direction from well? South How many feet? 25'

FROM	TO	LITHOLOGIC LOG	FROM	TO	PLUGGING INTERVALS
0"	5'	Topsoil, Black			(Well # Galva 05-02)
5'	20'	Clay, BRN, to gray, some caliche	5'-15'		
20'	30'	Sand, BRN, fine, some gray clay			
30'	36'	Clay, gray to green, some caliche, some red-brn, sandy clay			
36'	45'	Clay, Lt BRN, caliche, some med sand at 42'			
45'	56'	Sand, Lt. BRN to tan, med. some blue green shale clayey tan			
56'	60'	Sandy clay, tan, plastic, caliche			
60'	70'	Sandy clay, tan to red, caliche			
70'	75'	Sand, med, limonite, gray clay some reddish clay.			
75'	85'	Sand, BRN clay, fine to med. limonite/hematite, some blue green shale, some olive green shale, med. grains 80-85			
85'	90'	Shale, olive green to 87' (Wellington shale) some BRN shale to 89' then blue gray to 90'			

7 CONTRACTOR'S OR LANDOWNER'S CERTIFICATION: This water well was (1) constructed, (2) reconstructed, or (3) plugged under my jurisdiction and was completed on (mo/day/year) 7-2-02 and this record is true to the best of my knowledge and belief. Kansas Water Well Contractor's Licence No. 665 This Water Well Record was completed on (mo/day/yr) 10-1-02 under the business name of PRATT WELL ENVIRONMENTAL by (signature) Steve Egan

# KANSAS

CORPORATION COMMISSION

KATHLEEN SEBELIUS, GOVERNOR  
BRIAN J. MOLINE, CHAIR  
ROBERT E. KREHBIEL, COMMISSIONER  
MICHAEL C. MOFFET, COMMISSIONER

March 29, 2005

Bureau of Water  
Environmental  
Attn: Geology Section  
1000 South West Jackson Suite#420  
Topeka, Kansas 66612-1367

Re: Corrected water Well Location  
Monitoring wells KCC  
McPherson County

Dear Sir:

Enclosed are copies of the WWC5 as in database. Corrections have been marked on the forms. While I was working with the KGS water well database when I noticed that the correction on this project had not been sent to you. If you have any questions please call.

Sincerely



Bill Johnson  
Environmental Geologist

C: file

RECEIVED  
MAR 31 2005  
BUREAU OF WATER

COPY

RUNNING TURKEY CREEK  
ERRORS IN THE FINAL REPORT BY T & C MFG OPER.

SECTION 1: WELL LOCATIONS & SURVEY DATA SHEET

1. There are two topographic maps submitted with this report that show the locations for the monitoring wells. The first map shows the locations for the monitoring wells in the Elyria area, and the second shows the locations for monitoring wells in the Galva area. The Elyria map does not show the locations for monitoring wells 17-02, 18-02 or 19-02, and the Galva area map show the original locations for monitoring wells 2-02, 5-02, and 6-02, which had to be moved due to drilling obstructions such as pipelines.
2. Following the topographic maps is a spreadsheet listing all spot location data for monitoring wells that were completed and not plugged. Well locations are wrong for monitoring wells 2-02, 5-02, 6-02, 13-02, 15-02, and 16-02. It is assumed that the Lat./Long coordinates for these wells are also wrong. As stated above some locations were moved due to drilling obstructions, and were not re-shot with a GPS unit, but all errors include the wrong section and spot locations
3. The survey work done by Melanie L. Thrower is very vague, and uses <sup>some</sup> monitoring well numbers that were not designated numbers by Bill Johnson. This survey only gives the monitoring well numbers and the elevations for the Top of Casings. There is no confirming what sec-twp-rge or location she was in when doing the survey work. The survey did not include MW 15-02, but shows two surveys for 16-02. There is a 16-B-02 and a 16-02(s). It appears by looking at the elevations the 16-02(s), (s for south) corresponds to MW 15-02, but again without having a spot location this is only a good guess.

SECTION 2: DAILY JOB LOG

1. This section has limited information and it appears Geostat didn't keep a daily log from 6-8-02 to 7-30-02. Their logbook does have dates for when the wells were developed.

SECTION 3: WELL INFORMATION SECTION; WELL LOG, WWWC-5 FORM, LOG OF TEST BORING

1. MW 1-02 OK
- ✓2. MW 2-02 Has the original location on the well log which was copied onto the WWWC-5 form. Wrong spot, section and Lat./Long coordinates.
3. MW 3-02 OK
4. MW 4-02 OK

RECEIVED  
MAR 31 2005  
BUREAU OF WATER

COPY

- ✓ 5. MW 5-02 Has the original location on the well log which was copied onto the WWC-5 form. Wrong spot, section and Lat./Long coordinates.
- ✓ 6. MW 6-02 Has the original location on the well log which was copied onto the WWC-5 form. Wrong spot, section and Lat./Long coordinates.
7. MW 7-02 OK
8. MW 8-02 PLUGGED. Well log indicated TD was 45'. Bill Johnson's field notes indicate TD was 40'.
9. MW 9-02 PLUGGED. The lithologic description in this report is for MW 11-02, not 9-02. The wrong log was probably used when typing up the report. The TD for 9-02 was 35', not 63'. Location in the report is correct for 9-02. WWC-5 form also has correct location for 9-02, but the rest of the lithologic log is for MW 11-02 as well.
10. MW 10-02 OK
11. MW 11-02 PLUGGED. NO REPORT SUBMITTED.
12. MW 12-02 OK
- ✓ 13. MW 13-02 Wrong spot location and section. WWC5 form also reflects the wrong spot location and section. Wrong Lat./Long?
14. MW 14-02 OK
- ✓ 15. MW 15-02 Wrong spot location and section. WWC5 form also reflects the wrong spot location and section. Wrong Lat./Long?
- ✓ 16. MW 16-02 Wrong spot location and section. WWC5 form also reflects the wrong spot location and section. Wrong Lat./Long?
17. MW 17-02 OK
18. MW 18-02 OK
19. MW 19-02 10' of screen and 64' of pipe run, not 66' of pipe run. WWC5 form OK