


1 LOCATION OF WATER WELL:		Fraction	Section Number	Township Number	Range Number
County:	McPherson	SW ¼ SW ¼ SW ¼	1	T 19 S	R 2W E/W

Distance and direction from nearest town or city street address of well if located within city?

2 miles East of Galva. 3 1/8 North. East side.

2	WATER WELL OWNER:	Blackstone Drilling Company :Owner: San Unruh, RR Galva, KS 67460
	RR#, St. Address, Box # :	P.O. Box 1184
	City, State, ZIP Code :	McPherson, KS 67460
		Board of Agriculture, Division of Water Resources
		Application Number: T81-960

3	LOCATE WELL'S LOCATION WITH AN "X" IN SECTION BOX:	4	DEPTH OF COMPLETED WELL..... 60	ft.	ELEVATION:..... 12
			Depth(s) Groundwater Encountered..... 25	ft.	

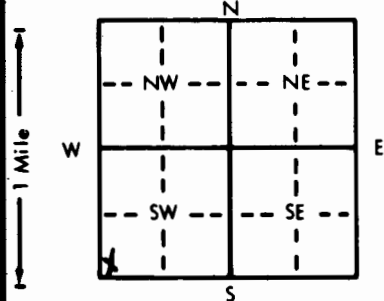

4) DEPTH OF COMPLETED WELL. 60 ft. ELEVATION: 12

Depth(s) Groundwater Encountered 1. 25 ft. 2. ft. 3. ft.

WELL'S STATIC WATER LEVEL 25' 6" ft. below land surface measured on mo/day/yr 1/4/82

Pump test data: Well water 30 ft. after 1 hours pumping 45 gpm

Est. Yield 70 gpm: Well water was 50 ft. after 2 hours pumping 70 gpm

Bore Hole Diameter 9 in. to 60 ft. and in. to ft.

WELL WATER TO BE USED AS:

1 Domestic	3 Feedlot	6 Oil field water supply	9 Dewatering	11 Injection well
2 Irrigation	4 Industrial	7 Lawn and garden only	10 Observation well	12 Other (Specify below)

Was a chemical/bacteriological sample submitted to Department? Yes.....No...~~XXX~~...; If yes, mo/day/yr sample was submitted

Water Well Disinfected? Yes No ~~XX~~

5 TYPE OF BLANK CASING USED:		5 Wrought iron	8 Concrete tile	CASING JOINTS: Glued .. XX Clamped
1 Steel	3 RMP (SR)	6 Asbestos-Cement	9 Other (specify below)	Welded
2 PVC	4 ABS	7 Fiberglass		Threaded
Blank casing diameter .. XX 3 in. to XX 40 ft. Dia ..		in. to .. ft. Dia ..		in. to .. ft.
Casing height above land surface .. 18 in. weight .. 160 lbs./ft. Wall thickness or gauge No. .. .216				

TYPE OF SCREEN OR PERFORATION MATERIAL:			7 PVC	10 Asbestos-cement
1 Steel	3 Stainless steel	5 Fiberglass	8 RMP (SR)	11 Other (specify)
2 Brass	4 Galvanized steel	6 Concrete tile	9 ABS	12 None used (open hole)

SCREEN OR PERFORATION OPENINGS ARE:		5 Gauzed wrapped	<u>8 Saw cut</u>	11 None (open hole)
1 Continuous slot	3 Mill slot	6 Wire wrapped	9 Drilled holes	
2 Louvered shutter	4 Key punched	7 Torch cut	10 Other (specify)	

SCREEN-PERFORATED INTERVALS: From 40 ft. to 60 ft., From ft. to ft.
From ft. to ft., From ft. to ft.
GRAVEL PACK INTERVALS: From 10 ft. to 60 ft., From ft. to ft.
From ft. to ft., From ft. to ft.

6 GROUT MATERIAL: 1 Neat cement 2 Cement grout 3 Bentonite 4 Other
Grout intervals: From 0 ft. to 10 ft. From ft. to ft. From ft. to ft. From ft. to ft.

What is the nearest source of possible contamination:

1 Septic tank	4 Lateral lines	7 Pit privy	10 Livestock pens	14 Abandoned water well
2 Sewer lines	5 Cess pool	8 Sewage lagoon	11 Fuel storage	<u>15 Oil well/Gas well</u>
3 Watertight sewer lines	6 Seepage pit	9 Feedyard	12 Fertilizer storage	16 Other (specify below)
Direction from well?	South		13 Insecticide storage
			How many feet?	1/2 Mile

[illegible]

7 CONTRACTOR'S OR LANDOWNER'S CERTIFICATION: This water well was (1) constructed, (2) reconstructed, or (3) plugged under my jurisdiction and was completed on (mo/day/year) 1/4/82 and this record is true to the best of my knowledge and belief. Kansas Water Well Contractor's License No. 134 This Water Well Record was completed on (mo/day/yr) 1/4/82 under the business name of Rosencrantz-Bemis Ent. by (signature) Dan S. Rosencrantz

INSTRUCTIONS: Use typewriter or ball point pen, PLEASE PRESS FIRMLY and PRINT clearly. Please fill in blanks, underline or circle the correct answers. Send top three copies to Kansas Department of Health and Environment, Division of Environment, Environmental Geology Section, Topeka, KS 66620. Send one to WATER WELL OWNER and retain one for your records.