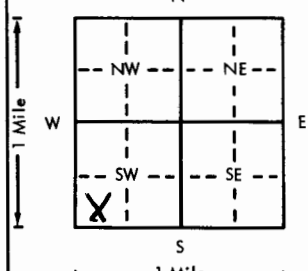


USE TYPEWRITER OR BALL  
POINT PEN-PRESS FIRMLY,  
PRINT CLEARLY.

WATER WELL RECORD  
KSA 82a-1201-1215

Kansas Department of Health and  
Environment-Division of Environment  
(Water well Contractors)  
Topeka, Kansas 66620

1. Location of well:		County <u>McPherson</u>	Fraction <u>SW 1/4 SW 1/4 SW 1/4</u>	Section number <u>2</u>	Township number <u>T 19 S R 2 E</u>	Range number <u>2</u>
2. Distance and direction from nearest town or city: <u>3 N 1 1/4 E</u>		3. Owner of well: <u>Gene Becker</u> R.R. or street: <u>410 N Main</u> City, state, zip code: <u>Canton Ks.</u>				
Street address of well location if in city: <u>Galva</u>						
4. Locate with "X" in section below:		Sketch map:				
						
5. Type and color of material		From	To	6. Bore hole dia. <u>6</u> in. Completion date <u>7-11-77</u> Well depth <u>61</u> ft.		
<u>Top Soil</u>		<u>0</u>	<u>2</u>	7. <input checked="" type="checkbox"/> Cable tool <input checked="" type="checkbox"/> Rotary <input type="checkbox"/> Driven <input type="checkbox"/> Dug <input type="checkbox"/> Hollow rod <input type="checkbox"/> Jetted <input type="checkbox"/> Bored <input type="checkbox"/> Reverse rotary		
<u>Red + yellow Clay</u>		<u>2</u>	<u>22</u>	8. Use: <input checked="" type="checkbox"/> Domestic <input type="checkbox"/> Public supply <input type="checkbox"/> Industry <input type="checkbox"/> Irrigation <input type="checkbox"/> Air conditioning <input type="checkbox"/> Stock <input type="checkbox"/> Lawn <input type="checkbox"/> Oil field water <input type="checkbox"/> Other		
<u>fine Sand</u>		<u>22</u>	<u>35</u>	9. Casing: Material <u>PRC</u> Height: Above or below Threaded <input type="checkbox"/> Welded <input type="checkbox"/> Surface <u>24</u> in. RMP <input type="checkbox"/> PVC <input checked="" type="checkbox"/> Weight <u>240</u> lbs./ft. Dia. <u>5</u> in. to <u>61</u> ft. depth Wall Thickness: inches or Dia. <u>5</u> in. to <u>61</u> ft. depth gage No. <u>258</u>		
<u>yellow Clay</u>		<u>35</u>	<u>45</u>	10. Screen: Manufacturer's name <u>Certain Deed</u> Type <u>PRC</u> Dia. <u>5-11</u> Slot/gauze <u>40</u> Length <u>10'</u> Set between <u>47</u> ft. and <u>57</u> ft. Gravel pack? <input checked="" type="checkbox"/> Size range of material <u>4-20</u>		
<u>Medium Sand</u>		<u>45</u>	<u>58</u>	11. Static water level: <u>27</u> ft. below land surface Date <u>2-11-77</u> mo./day/yr.		
<u>yellow Shale</u>		<u>58</u>	<u>61</u>	12. Pumping level below land surfaces: ____ ft. after ____ hrs. pumping ____ g.p.m. ____ ft. after ____ hrs. pumping ____ g.p.m. Estimated maximum yield ____ g.p.m.		
				13. Water sample submitted: ____ mo./day/yr. Yes <input checked="" type="checkbox"/> No <input type="checkbox"/> Date ____		
				14. Well head completion: <input checked="" type="checkbox"/> Pitless adapter ____ Inches above grade		
				15. Well grouted? <input checked="" type="checkbox"/> With: <input checked="" type="checkbox"/> Neat cement <input type="checkbox"/> Bentonite <input type="checkbox"/> Concrete Depth: From <u>3</u> ft. to <u>13</u> ft.		
				16. Nearest source of possible contamination: <u>Septic</u> ft. <u>50</u> Direction <u>SW</u> Type <u>Trunk</u> Well disinfected upon completion? <input checked="" type="checkbox"/> Yes <input type="checkbox"/> No		
				17. Pump: <input checked="" type="checkbox"/> Not installed Manufacturer's name ____ Model number ____ HP ____ Volts ____ Length of drop pipe ____ ft. capacity ____ g.p.m. Type: <input type="checkbox"/> Submersible <input type="checkbox"/> Turbine <input type="checkbox"/> Jet <input type="checkbox"/> Reciprocating <input type="checkbox"/> Centrifugal <input type="checkbox"/> Other		
18. Elevation:		19. Remarks:		20. Water well contractor's certification: This well was drilled under my jurisdiction and this report is true to the best of my knowledge and belief. <u>Backhus Drgl. 180</u> Business name <u>Tampa Ks.</u> License No. ____ Address <u>Paul Backhus</u> Date <u>7-13-77</u> Signed <u>Paul Backhus</u> Authorized representative		
Topography: <input type="checkbox"/> Hill <input type="checkbox"/> Slope <input checked="" type="checkbox"/> Upland <input type="checkbox"/> Valley						

19 - 20 - 2  
1/4 1/4 1/4