


WATER WELL RECORD Form WWC-5 KSA 82a-1212

Distance and direction from nearest town or city street address of well if located within city?

2] WATER WELL OWNER: BIG KAT INC. DUNKELBURGER, GALVA, KS
RR#, St. Address, Box #: BOX 18154 Board of Agriculture, Division of Water Resources
City, State, ZIP Code: WICHITA KS 67218 Application Number: 783-165

SEE "A" IN SECTION BOX:

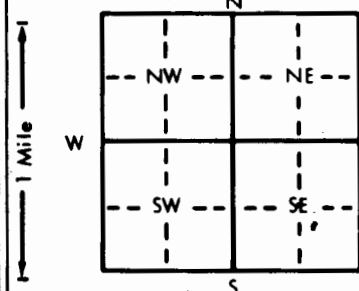

Depth(s) Groundwater Encountered 1. ft. 2. ft. 3. ft.

Pump test data: Well water was _____ ft after _____ hours pumping _____ gpm

Base Hole Diameter 3 7/8 in. to 60 ft. and in. to ft.

WELL WATER TO BE USED AS: 5 Public water supply 8 Air conditioning 11 Injection well

2 Irrigation 4 Industrial 7 Lawn and garden only 10 Observation well

Water Well Disinfected?	
Yes	No
mitted	

TYPE OF BEAM CASING USED:		5 Wrought iron	8 Concrete tile	CASING JOINTS: Graded / Stamped
1 Steel	3 RMP (SR)	6 Asbestos-Cement	9 Other (specify below)	Welded

Blank, round, diameter	2 PVC	4 ABS	7 Fiberglass	Threaded
in. to	in. to	in. to	in. to	in. to
40				

Casing height above land surface 12 in., weight 26.5 lbs./ft. Wall thickness or gauge No. 11.9

1 Steel	3 Stainless steel	5 Fiberglass	8 RMP (SR)	11 Other (specify)
---------	-------------------	--------------	------------	------------------------------

SCREEN OR PERFORATION OPENINGS ARE: 1/8 5 Gauzed wrapped 8 Saw cut 11 None (open hole)

1 Continuous slot	5 Mill slot	9 Wire wrapped	9 Drilled holes
2 Louvered shutter	4 Key punched	7 Torch cut	10 Other (specify)

SCREEN-PERFORATED INTERVALS: From 10 ft. to 60 ft., From ft. to ft.
From ft. to ft. From ft. to ft.

GRAVEL PACK INTERVALS: From.....10.....ft. to.....60.....ft., From.....ft. to.....ft.

6] GROUT MATERIAL: 1 Neat cement 2 Cement grout 3 Bentonite 4 Other

What is the nearest source of possible contamination: NONE 10 Livestock pens 14 Abandoned water well

1 Septic tank	4 Lateral lines	7 Pit privy	11 Fuel storage	15 Oil well/gas well
2 Sewer lines	5 Cess pool	8 Sewage lagoon	12 Fertilizer storage	16 Other (specify below)

3 Watertight sewer lines	6 Seepage pit	9 Feedyard	13 Insecticide storage	
Direction from #2			House, east	

FROM	TO	LITHOLOGIC LOG	FROM	TO	LITHOLOGIC LOG
1	11	6114 21			

[illegible][illegible][illegible][illegible][illegible][illegible][illegible][illegible]

7 CONTRACTOR'S OR LANDOWNER'S CERTIFICATION: This water well was (1) constructed, (2) reconstructed, or (3) plugged under my jurisdiction and was

Water Well Contractor's License No. 389 This Water Well Record was completed on (mo/day/yr) 5-3-83

INSTRUCTIONS: Use typewriter or ball point pen, PLEASE PRESS FIRMLY and PRINT clearly. Please fill in blanks, underline or circle the correct answers. Send top

OWNER and retain one for your records.