


1 LOCATION OF WATER WELL: County: **McPherson** Fraction **SW 1/4 NW 1/4 NW 1/4** Section Number **14** Township Number **T 19 S** Range Number **R 2** **EMK**

Distance and direction from nearest town or city street address of well if located within city?
1 miles east and 1 3/4 miles north of Galva, KS.

2 WATER WELL OWNER: **Homer Krehbiel**
 RR#, St. Address, Box #: **1343 N. Maple**
 City, State, ZIP Code: **McPherson, KS.**
 Board of Agriculture, Division of Water Resources
 Application Number:

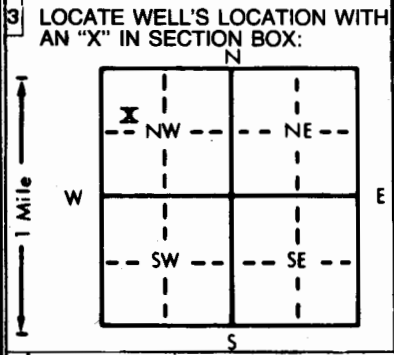

4 DEPTH OF COMPLETED WELL: **65** ft. ELEVATION: ft.
 Depth(s) Groundwater Encountered 1. **20** ft.; 2. ft. 3. ft.
 WELL'S STATIC WATER LEVEL **20** ft. below land surface measured on mo/day/yr **8-5-82**
 Pump test data: Well water was ft. after hours pumping gpm
 Est. Yield **30-40** gpm: Well water was ft. after hours pumping gpm
 Bore Hole Diameter: **8** in. to **65** ft., and in. to ft.
 WELL WATER TO BE USED AS:
 5 Public water supply 8 Air conditioning 11 Injection well
 1 Domestic 3 Feedlot **XX 6 Oil field water supply** 9 Dewatering 12 Other (Specify below)
 2 Irrigation 4 Industrial 7 Lawn and garden only 10 Observation well
 Was a chemical/bacteriological sample submitted to Department? Yes.....No **XX**.....; If yes, mo/day/yr sample was submitted
 Water Well Disinfected? Yes **XX** No

5 TYPE OF BLANK CASING USED:
 1 Steel **XX 2 PVC** 3 RMP (SR) 4 ABS 5 Wrought iron 6 Asbestos-Cement 7 Fiberglass 8 Concrete tile 9 Other (specify below)
 Blank casing diameter in. to **XX 45** ft., Dia **XXX** in. to ft., Dia in. to ft.
 Casing height above land surface: **12** in., weight **.91** lbs./ft. Wall thickness or gauge No. **135**
 TYPE OF SCREEN OR PERFORATION MATERIAL:
 1 Steel 2 Brass 3 Stainless steel 4 Galvanized steel 5 Fiberglass 6 Concrete tile 7 PVC 8 RMP (SR) 9 ABS 10 Asbestos-cement 11 Other (specify) 12 None used (open hole)
 SCREEN OR PERFORATION OPENINGS ARE:
 1 Continuous slot **XX 3 Mill slot** 5 Gauzed wrapped 6 Wire wrapped 7 Torch cut 8 Saw cut 9 Drilled holes 10 Other (specify) 11 None (open hole)
 SCREEN-PERFORATED INTERVALS: From **45** ft. to **65** ft., From ft. to ft.
 From **15** ft. to **65** ft., From ft. to ft.
 GRAVEL PACK INTERVALS: From ft. to ft., From ft. to ft.

6 GROUT MATERIAL: **XX 1 Neat cement** 2 Cement grout 3 Bentonite 4 Other
 Grout Intervals: From **5** ft. to **15** ft., From ft. to ft., From ft. to ft.
 What is the nearest source of possible contamination:
 1 Septic tank 2 Sewer lines 3 Watertight sewer lines 4 Lateral lines 5 Cess pool 6 Seepage pit 7 Pit privy 8 Sewage lagoon 9 Feedyard 10 Livestock pens 11 Fuel storage 12 Fertilizer storage 13 Insecticide storage 14 Abandoned water well 15 Oil well/Gas well 16 Other (specify below)
 Direction from well? **EAST** How many feet? **75 ft**

FROM	TO	LITHOLOGIC LOG	FROM	TO	LITHOLOGIC LOG
0	5	Top soil			
5	11	Brown clay			
11	20	Sandy brown clay & fine sand			
20	31	Fine sand			
31	50	Medium sand (brown)			
50	65	Medium sand (green)			

7 CONTRACTOR'S OR LANDOWNER'S CERTIFICATION: This water well was (1) constructed, (2) reconstructed, or (3) plugged under my jurisdiction and was completed on (mo/day/year) **9-27-82** and this record is true to the best of my knowledge and belief. Kansas Water Well Contractor's License No. **138** This Water Well Record was completed on (mo/day/yr) **9-27-82** under the business name of **Peterson Irrigation, Inc.** by (signature) **Mike Peterson**
 INSTRUCTIONS: Use typewriter or ball point pen, PLEASE PRESS FIRMLY and PRINT clearly. Please fill in blanks, underline or circle the correct answers. Send top three copies to Kansas Department of Health and Environment, Division of Environment, Environmental Geology Section, Topeka, KS 66620. Send one to WATER WELL OWNER and retain one for your records.