


USE TYPEWRITER OR BALL POINT PEN-PRESS FIRMLY, PRINT CLEARLY.

WATER WELL RECORD
KSA 82a-1201-1215

Kansas Department of Health and Environment-Division of Environment
(Water well Contractors)
Topeka, Kansas 66620

1. Location of well: County Mcpherson Fraction Se 1/4 Ne 1/4 Ne 1/4 Section number 16 Township number T 19 S R 2 Range number EW

2. Distance and direction from nearest town or city: 1 1/2 N
Street address of well location if in city: Galva
3. Owner of well: Loren Koehn
R.R. or street: BBI
City, state, zip code: Galva, Ks. 67443

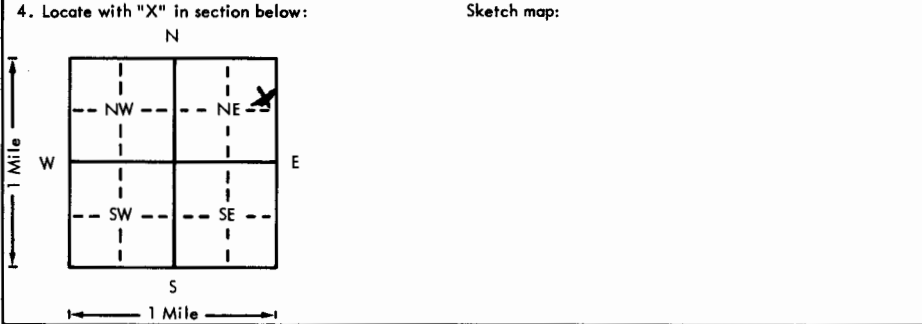

6. Bore hole dia. 10 in. Completion date 4-22-76
Well depth 62 ft.
7. Cable tool Rotary Driven Dug
 Hollow rod Jetted Bored Reverse rotary
8. Use: Domestic Public supply Industry
 Irrigation Air conditioning Stock
 Lawn Oil field water Other
9. Casing: Material PRC Height: Above or below
Threaded Welded Surface 12 in.
RMP PYC Weight 160 lbs./ft.
Dia. 5 in. to 62 ft. depth Wall Thickness: inches or
Dia. 5 in. to 62 ft. depth gage No. 0229

5. Type and color of material

	From	To
Top Soil	0	3
yellow clay	3	35
fine sand	35	40
yellow clay	40	45
medium gravel	45	55
Red clay	55	62

10. Screen: Manufacturer's name Pumpco
Type PRC Dia. 5
Slot/gauze 70 Length 10
Set between 45 ft. and 55 ft.
Gravel pack? Size range of material 14
11. Static water level: 30 ft. below land surface Date 4-22-76
12. Pumping level below land surfaces:
 ft. after hrs. pumping g.p.m.
 ft. after hrs. pumping g.p.m.
Estimated maximum yield g.p.m.
13. Water sample submitted: mo./day/yr.
 Yes No Date
14. Well head completion: Well House
 Pitless adapter 12 Inches above grade
15. Well grouted?
With: Neat cement Bentonite Concrete
Depth: From 0 ft. to 10 ft.
16. Nearest source of possible contamination: Septic
ft. 80 Direction E Type Tank
Well disinfected upon completion? Yes No
17. Pump: Not installed
Manufacturer's name
Model number HP Volts
Length of drop pipe ft. capacity g.p.m.
Type:
 Submersible Turbine
 Jet Reciprocating
 Centrifugal Other

18. Elevation:
19. Remarks: Pump not installed by my company

20. Water well contractor's certification:
This well was drilled under my jurisdiction and this report is true to the best of my knowledge and belief.
Bachhus Drg 180
Business name Jampa, Ks. License No.
Address
Signed Doug Bachhus Date 5-28-76
Authorized representative

12-20-16 SENE