


1 LOCATION OF WATER WELL: County: **McPherson** Fraction: **SE 1/4 NW 1/4 NE 1/4** Section Number: **22** Township Number: **T 19 S** Range Number: **R 2 EW**

Distance and direction from nearest town or city street address of well if located within city?
1/2 mile west of Galva, KS.

2 WATER WELL OWNER: **Marilyn HARWOOD**
 RR#, St. Address, Box #: **Box 428**
 City, State, ZIP Code: **GLASCO, KS, 67445**
 Board of Agriculture, Division of Water Resources
 Application Number: **783-49**

3 LOCATE WELL'S LOCATION WITH AN "X" IN SECTION BOX:

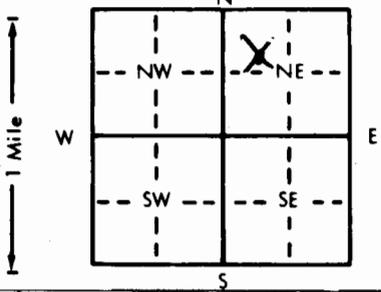

4 DEPTH OF COMPLETED WELL: **70** ft. ELEVATION:

Depth(s) Groundwater Encountered: **1. 25** ft. 2. ft. 3. ft.
 WELL'S STATIC WATER LEVEL: **25** ft. below land surface measured on **1-28-83** mo/day/yr
 Pump test data: Well water was ft. after hours pumping gpm
 Est. Yield **50-75** gpm: Well water was ft. after hours pumping gpm
 Bore Hole Diameter: **8** in. to **70** ft., and in. to ft.
 WELL WATER TO BE USED AS:
 1 Domestic 3 Feedlot **XX 6 Oil field water supply** 9 Dewatering 12 Other (Specify below)
 2 Irrigation 4 Industrial 7 Lawn and garden only 10 Observation well
 Was a chemical/bacteriological sample submitted to Department? Yes No **XX**; If yes, mo/day/yr sample was submitted
 Water Well Disinfected? Yes **XX** No

5 TYPE OF BLANK CASING USED:
 1 Steel 3 RMP (SR) 5 Wrought iron 8 Concrete tile CASING JOINTS: Glued **XX** Clamped
XX 2 PVC 4 ABS 6 Asbestos-Cement 9 Other (specify below) Welded
 7 Fiberglass Threaded
 Blank casing diameter: **3** in. to **70** ft., Dia in. to ft., Dia in. to ft.
 Casing height above land surface: **12** in., weight: **.91** lbs./ft. Wall thickness or gauge No. **135**

TYPE OF SCREEN OR PERFORATION MATERIAL:
 1 Steel 3 Stainless steel 5 Fiberglass 8 RMP (SR) 10 Asbestos-cement
 2 Brass 4 Galvanized steel 6 Concrete tile 9 ABS 12 None used (open hole)
 SCREEN OR PERFORATION OPENINGS ARE:
 1 Continuous slot **XX 8** Mill slot 5 Gauzed wrapped 8 Saw cut 11 None (open hole)
 2 Louvered shutter 4 Key punched 6 Wire wrapped 9 Drilled holes
 7 Torch cut 10 Other (specify)

SCREEN-PERFORATED INTERVALS: From **0** ft. to **50** ft., From ft. to ft.
 From ft. to ft., From ft. to ft.
 GRAVEL PACK INTERVALS: From **15** ft. to **70** ft., From ft. to ft.
 From ft. to ft., From ft. to ft.

6 GROUT MATERIAL: **Bentonite** Neat cement 2 Cement grout 4 Other
 Grout Intervals: From **5** ft. to **15** ft., From ft. to ft., From ft. to ft.

What is the nearest source of possible contamination:
 1 Septic tank 4 Lateral lines 7 Pit privy 10 Livestock pens 14 Abandoned water well
 2 Sewer lines 5 Cess pool 8 Sewage lagoon 11 Fuel storage **XX 15** Oil well/Gas well
 3 Watertight sewer lines 6 Seepage pit 9 Feedyard 12 Fertilizer storage 16 Other (specify below)
 13 Insecticide storage
 Direction from well? **northwest** How many feet? **80**

FROM	TO	LITHOLOGIC LOG	FROM	TO	LITHOLOGIC LOG
0	5	Top soil			
5	8	Buff clay			
8	16	Fine sand			
16	25	Sandy gray clay			
25	47	Fine to medium sand			
47	50	Gray clay			
50	69	Fine to medium sand			
69	70	Green shale			

7 CONTRACTOR'S OR LANDOWNER'S CERTIFICATION: This water well was (1) constructed, (2) reconstructed, or (3) plugged under my jurisdiction and was completed on (mo/day/year) **1-28-83** and this record is true to the best of my knowledge and belief. Kansas Water Well Contractor's License No. **138** This Water Well Record was completed on (mo/day/yr) **1-28-83** under the business name of **Peterson Irrigation, Inc.** by (signature) **Mike Peterson**

INSTRUCTIONS: Use typewriter or ball point pen, PLEASE PRESS FIRMLY and PRINT clearly. Please fill in blanks, underline or circle the correct answers. Send top three copies to Kansas Department of Health and Environment, Division of Environment, Environmental Geology Section, Topeka, KS 66620. Send one to WATER WELL OWNER and retain one for your records.