


In Galva 428 Mulberry

Board of Agriculture, Division of Water Resources
Application Number:

4 DEPTH OF COMPLETED WELL..... 33 ft. ELEVATION:

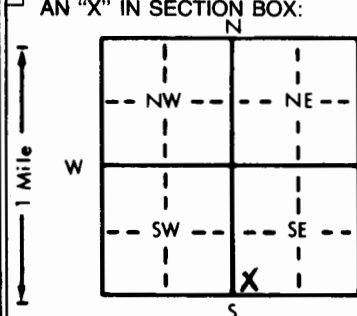

Depth(s) Groundwater Encountered 1. 25 ft. 2. _____ ft. 3. _____ ft.

WELL'S STATIC WATER LEVEL 17 ft. below land surface measured on mo/day/yr 7-15-85

Pump test data: Well water _____ ft. after _____ hours pumping _____ gpm

Est. Yield 25 gpm; Well water _____ ft. after _____ hours pumping _____ gpm

Bore Hole Diameter 9 in. to 33 ft., and _____ in. to _____ ft.

WELL WATER TO BE USED AS:

5 Public water supply	8 Air conditioning	11 Injection well		
1 Domestic	3 Feedlot	6 Oil field water supply	9 Dewatering	12 Other (Specify below)
2 Irrigation	4 Industrial	7 <u>Lawn and garden only</u>	10 Observation well	

Was a chemical/bacteriological sample submitted to Department? Yes.....No.....; If yes, mo/day/yr sample was submitted

Water Well Disinfected? Yes _____ No _____

CASING JOINTS: Glued . ~~X~~ Clamped

Welded
Threaded

Blank casing diameter 5 in. to 23 ft. Dia. in. to ft. Dia. in. to ft.
Casing height above land surface 15 in. weight C10SP160 lbs./ft. Wall thickness or gauge No. 318

7 PVC 10 Asbestos-cement

5 Fiberglass
6 Concrete tile

8 RMP (SR)
9 ABS

11 Other (specify)
12 None used (open hole)

5 Gauzed wrapped

8 Saw cut 11 None (open hole)

1 Continuous slot	3 Mill slot
2 Louvered shutter	4 Key punched

6 Wire wrapped
7 Torch cut

9 Drilled holes

11 None (open hole)

SCREEN-PERFORATED INTERVALS: From 23 ft. to 33 ft. From _____ ft. to _____ ft.

GRAVEL PACK INTERVALS: From 10 ft to 33 ft From _____ ft to _____ ft

6 GROUT MATERIAL: 1 Neat cement 2 Cement grout 3 Bentonite 4 Other

Grout intervals: From 0 ft. to 10 ft. From ft. to ft. From ft. to ft. From ft. to ft.

What is the nearest source of possible contamination:

1 Septic tank	4 Lateral lines
2 Sewer lines	5 Cess pool
3 Watertight sewer lines	6 Seepage pit

7 Pit privy
8 Sewage lagoon
9 Feedyard

10 Livestock pens	14 Abandoned water well
11 Fuel storage	15 Oil well/Gas well
12 Fertilizer storage	16 Other (specify below)
13 Insecticide storage	

Direction from well?

How many feet? 30

[illegible]

7 CONTRACTOR'S OR LANDOWNER'S CERTIFICATION: This water well was (1) constructed, (2) reconstructed, or (3) plugged under my jurisdiction and was completed on (mo/day/year) 7-15-85 and this record is true to the best of my knowledge and belief. Kansas Water Well Contractor's License No. 1200 This Water Well Record was completed on (mo/day/yr) 7-15-85 under the business name of Bachke Drilling by (signature) Paul Bachke

INSTRUCTIONS: Use typewriter or ball point pen, PLEASE PRESS FIRMLY and PRINT clearly. Please fill in blanks, underline or circle the correct answers. Send top three copies to Kansas Department of Health and Environment, Division of Environment, Environmental Geology Section, Topeka, KS 66620. Send one to WATER WELL OWNER and retain one for your records.