

1 LOCATION OF WATER WELL:	Fraction	Section Number	Township Number	Range Number
County: <u>Mpherson</u>	<u>SW 1/4 SW 1/4 SW 1/4</u>	<u>27</u>	T <u>19</u> S	R <u>2</u> E <u>(W)</u>

Distance and direction from nearest town or city street address of well if located within city?

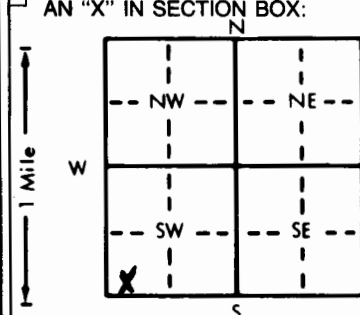
1 S Galva2 WATER WELL OWNER: Loren KoehnRR#, St. Address, Box #: RR 4

Board of Agriculture, Division of Water Resources

City, State, ZIP Code: Galva, Ks. 67443

Application Number:

3 LOCATE WELL'S LOCATION WITH AN "X" IN SECTION BOX:

4 DEPTH OF COMPLETED WELL: 54 ft. ELEVATION:Depth(s) Groundwater Encountered 1. 46 ft. 2. 46 ft. 3. 46 ft.WELL'S STATIC WATER LEVEL 12 ft. below land surface measured on mo/day/yr 7-6-84Pump test data: Well water was 20 gpm. Well water was 54 ft. after 9 hours pumping 20 gpm.Est. Yield 20 gpm. Well water was 54 ft. after 9 hours pumping 20 gpm.Bore Hole Diameter 9 in. to 54 ft. and 54 in. to 54 ft.

WELL WATER TO BE USED AS: 5 Public water supply 8 Air conditioning 11 Injection well

1 Domestic 3 Feedlot 6 Oil field water supply 9 Dewatering 12 Other (Specify below)

2 Irrigation 4 Industrial 7 Lawn and garden only 10 Observation well

Was a chemical/bacteriological sample submitted to Department? Yes X No X. If yes, mo/day/yr sample was submittedWater Well Disinfected? Yes X No

5 TYPE OF BLANK CASING USED:

5 Wrought iron

8 Concrete tile

CASING JOINTS: Glued X Clamped

1 Steel 3 RMP (SR)

6 Asbestos-Cement

9 Other (specify below)

Welded

2 PVC 4 ABS

7 Fiberglass

Threaded

Blank casing diameter 5 in. to 44 ft. Dia 12 in. to 160 ft. Dia 12 in. to 160 ft.Casing height above land surface 12 in. weight 160 lbs./ft. Wall thickness or gauge No. 2.14

TYPE OF SCREEN OR PERFORATION MATERIAL:

1 Steel 3 Stainless steel

5 Fiberglass

7 PVC

10 Asbestos-cement

2 Brass 4 Galvanized steel

6 Concrete tile

8 RMP (SR)

11 Other (specify)

12 None used (open hole)

SCREEN OR PERFORATION OPENINGS ARE:

1 Continuous slot 3 Mill slot

5 Gauzed wrapped

8 Saw cut

11 None (open hole)

2 Louvered shutter 4 Key punched

6 Wire wrapped

9 Drilled holes

3 Torched cut

10 Other (specify)

to 54 ft.7 CONTRACTOR'S OR LANDOWNER'S CERTIFICATION: This water well was (1) constructed, (2) reconstructed, or (3) plugged under my jurisdiction and was completed on (mo/day/year) 7-6-84 and this record is true to the best of my knowledge and belief. KansasWater Well Contractor's License No. 100 This Water Well Record was completed on (mo/day/yr) 7-17-84under the business name of Boeckhus Drilling by (signature) Paul BoeckhusINSTRUCTIONS: Use typewriter or ball point pen, PLEASE PRESS FIRMLY and PRINT clearly. Please fill in blanks, underline or circle the correct answers. Send top three copies to Kansas Department of Health and Environment, Division of Environment, Environmental Geology Section, Topeka, KS 66620. Send one to WATER WELL OWNER and retain one for your records.